



Faught Creek Spring

SCALE
4" = 1 mile

NORTH

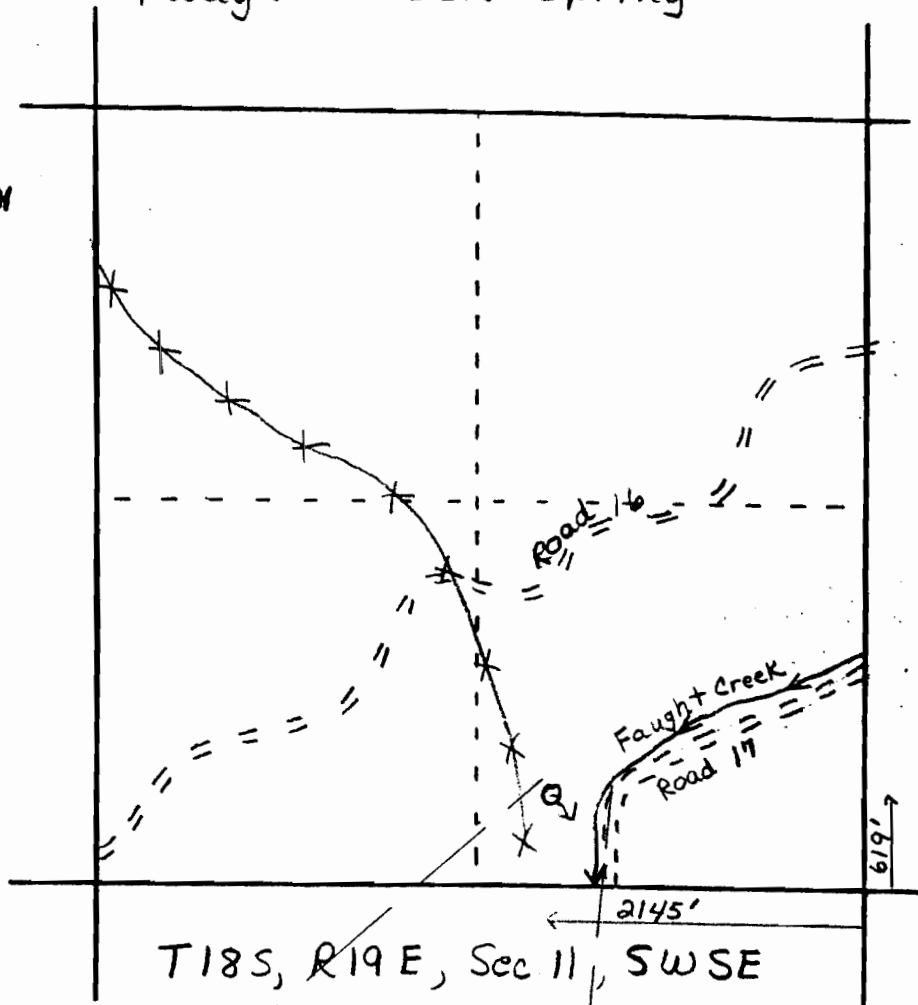

Application No. 66361
Permit No. 49546

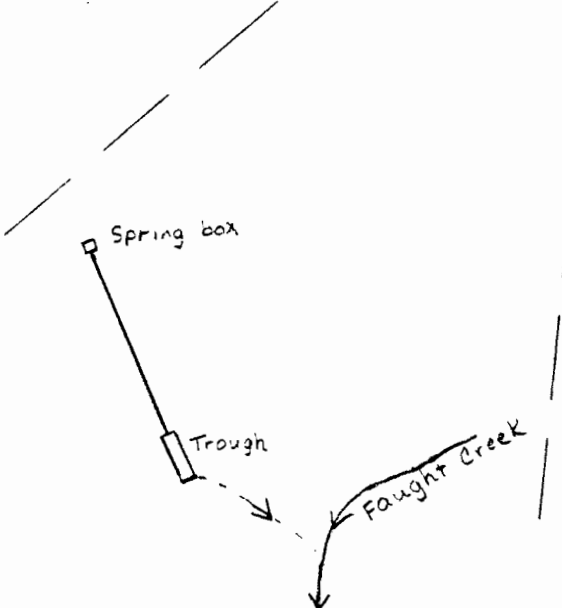

North

SEP 9 1983
V. L. ... DEPT.
SALEM, OREGON

Scale: 1 inch = 40 feet