


RECEIVED

SEP 18 1985

WATER RESOURCES DEPT
SALEM, OREGON

SCALE
4" = 1 mile


NORTH

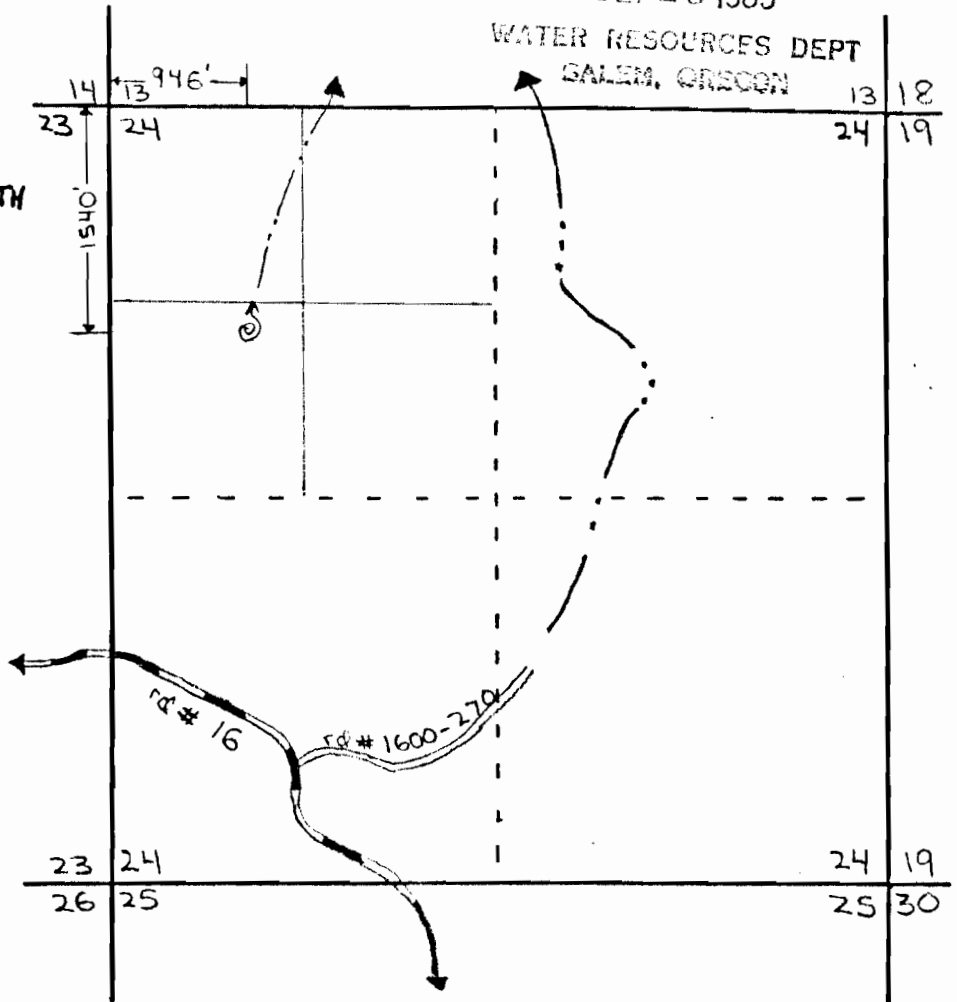

Rock Spring

T17S, R20E, Sec 24, SW 1/4 NW 1/4

Application No. 68551
Permit No. 49587

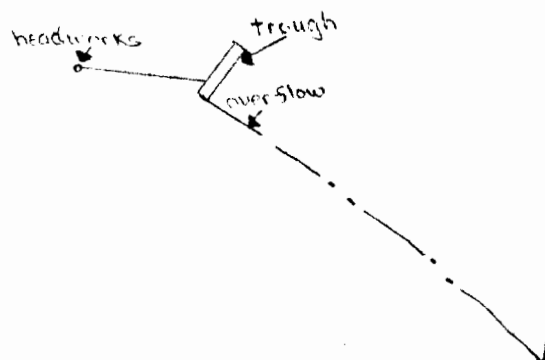

Scale = 1 inch
= 40 feet
North