


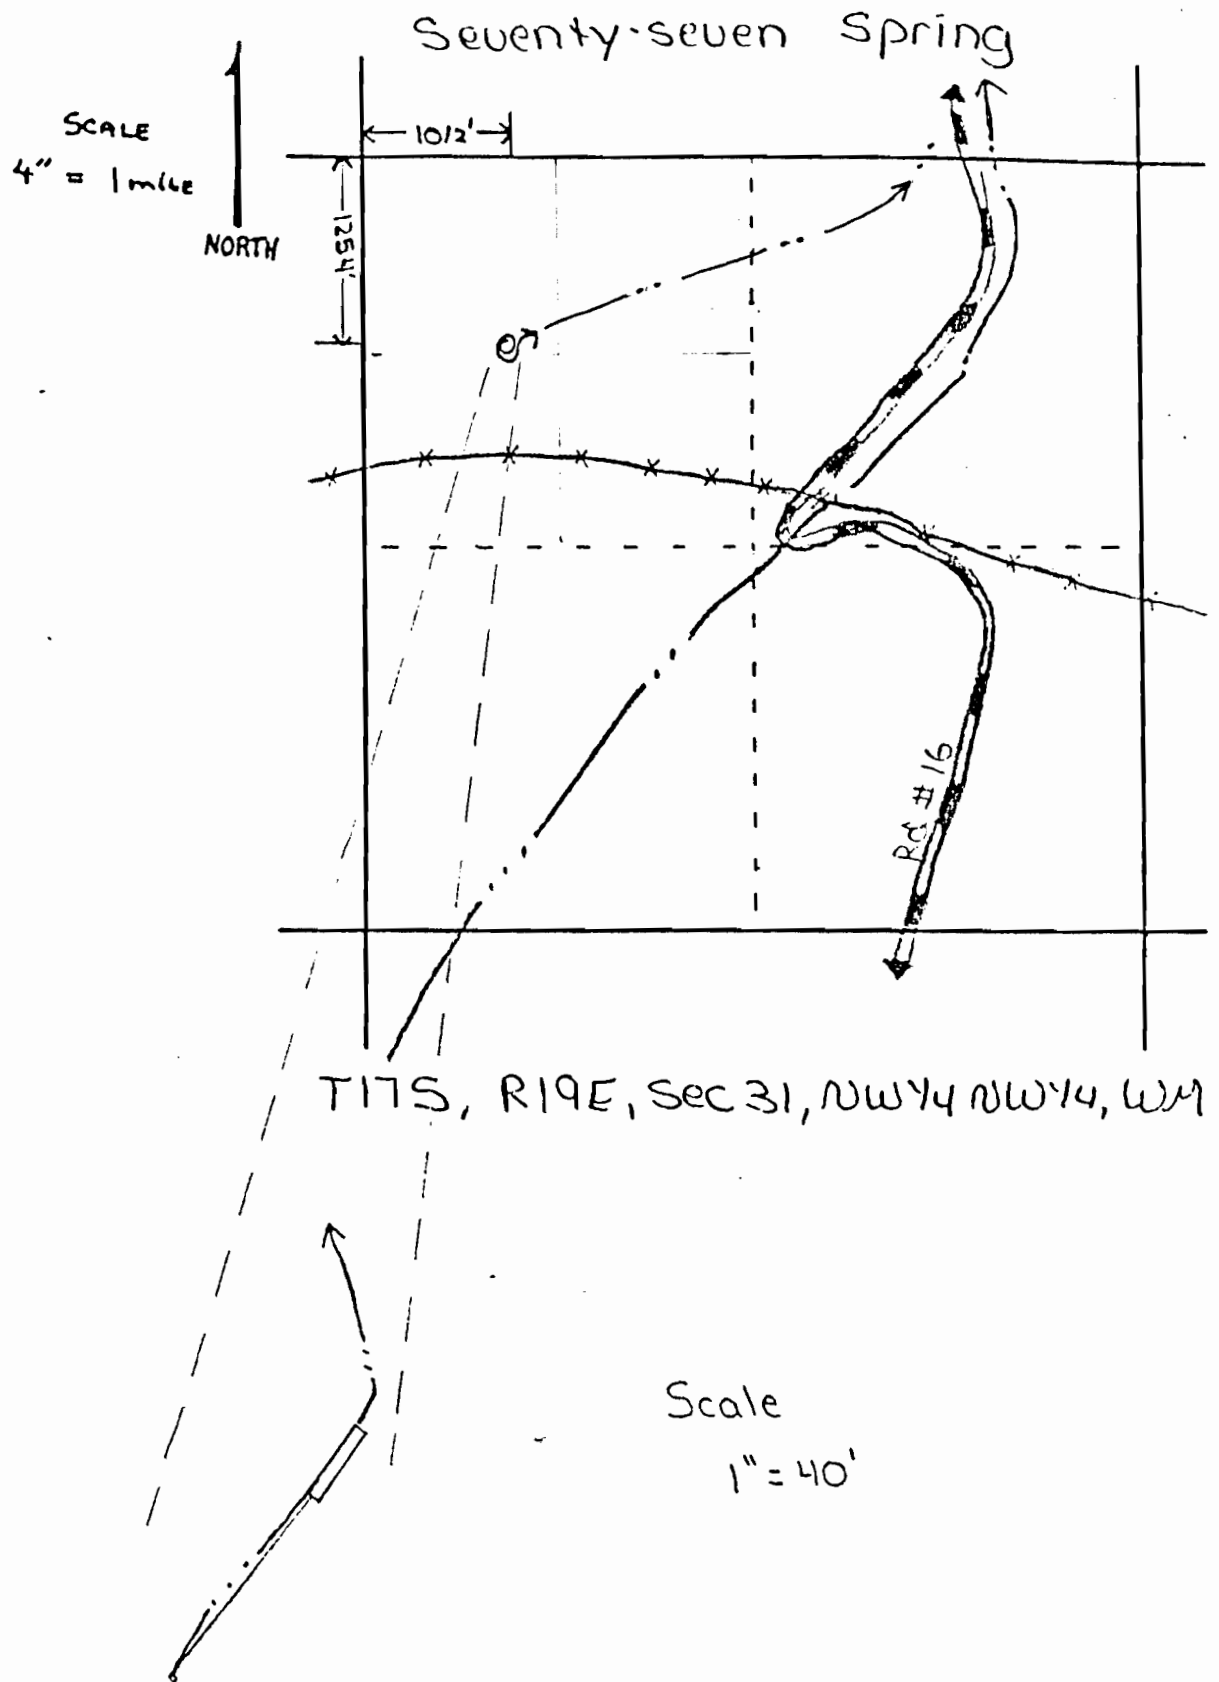

Application No. 68172
Permit No. 48959

RECEIVED
SEP 6 1984
WATER RESOURCES DEPT
SALEM, OREGON