


Gopher Spring

SCALE
4" = 1 mile

NORTH

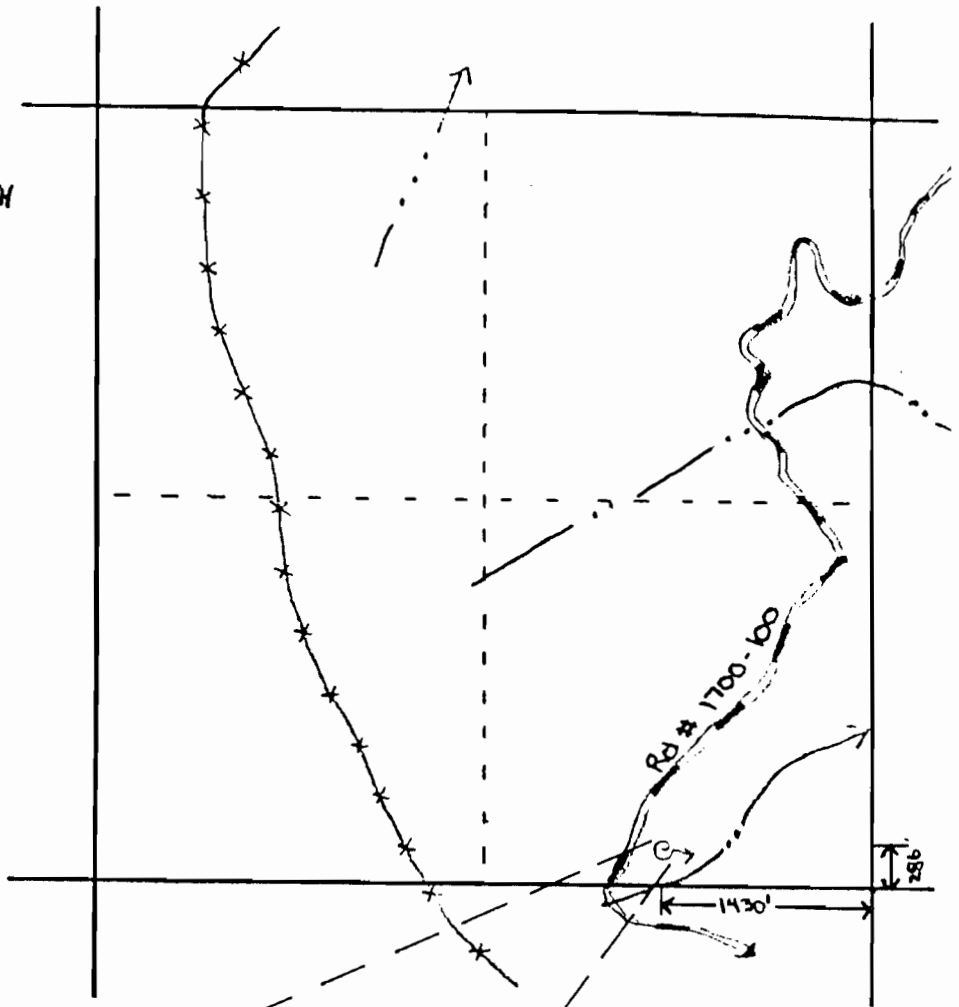

T17S, R19E, Sec 34, SW 1/4 SE 1/4, WM

Scale
1" = 40'

Application No. 68174
Permit No. 48961

RECEIVED

SEP 6 1984

WATER RESOURCES DEPT
SALEM, OREGON