


T.4S. R.1W. W.M.

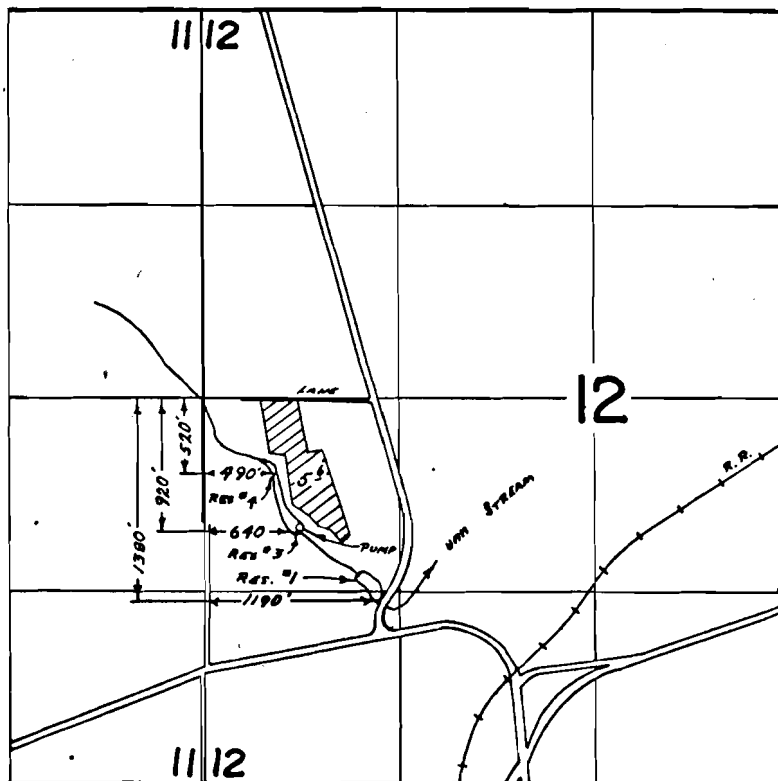

FINAL PROOF SURVEY UNDER

Application No. ⁴⁴⁵⁴²R-44541 Permit No. ³³³²⁶R-5275
IN NAME OF

RUDI KASEL

Surveyed MAY 25 1993, by T. J. PAUL