


T. 37 S., R. 2 W., W. M.

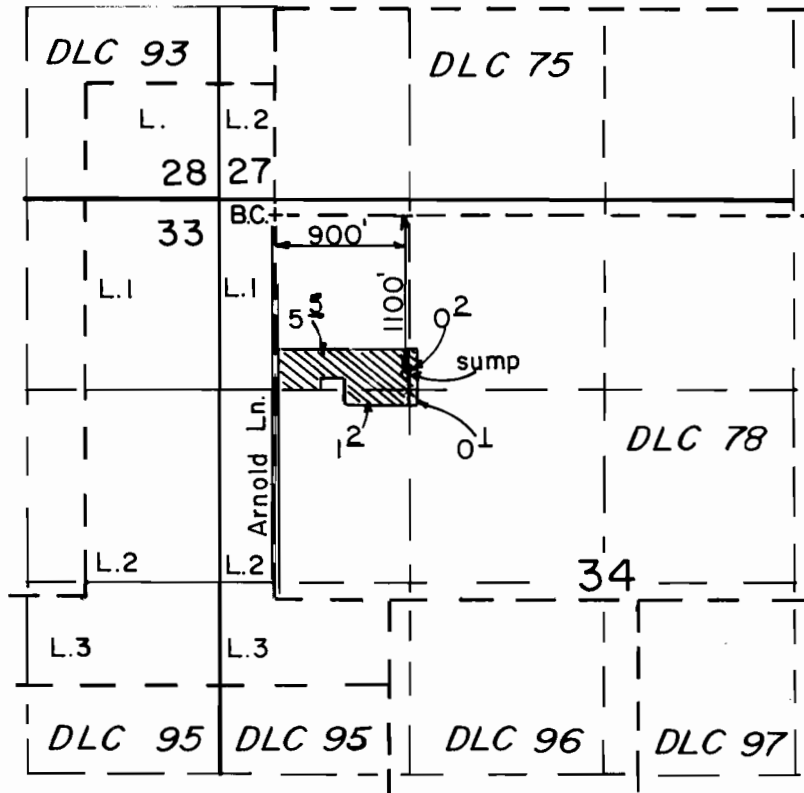

Scale: 1" = 1320'

FINAL PROOF SURVEY
UNDER

Application No. G:7942 Permit No. G:7326...
IN NAME OF

.....M...KEITH...BARCOCK.....

Surveyed JULY 9. 1991., by B...S...JAMES...