


T. 37 S., R. 2 W., W. M.

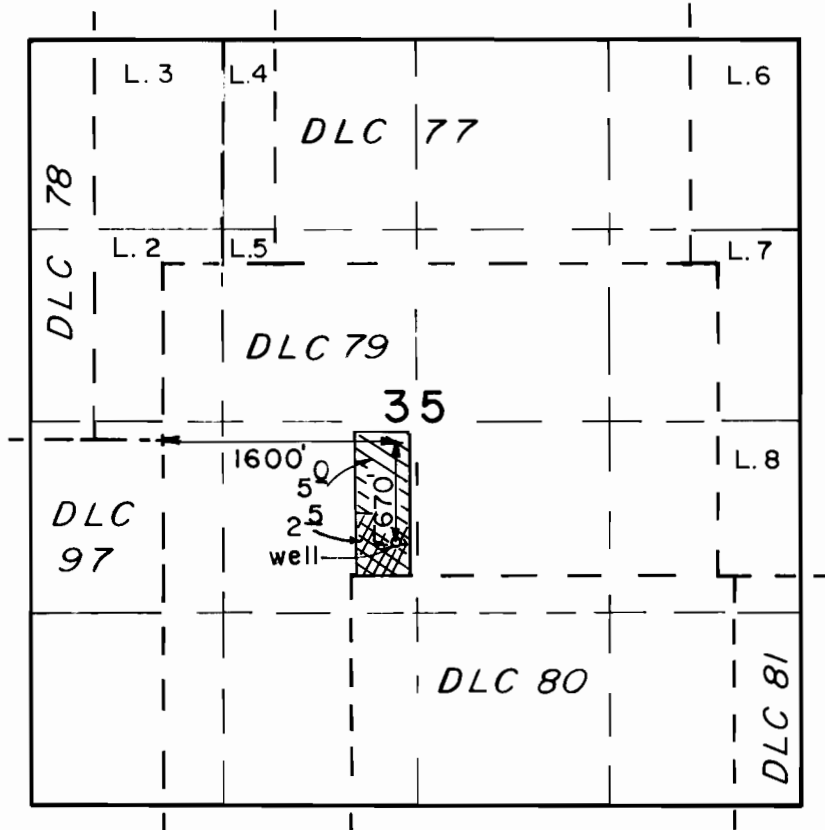

Scale: 1" = 1320'

**FINAL PROOF SURVEY**  
UNDER

Application No. G-9615 Permit No. G-9497....  
IN NAME OF

.....YOLANDA R. ENNER.....

Surveyed JULY 23, 1991., by B.S. JAMES...