


T. 26 S., R. 16 E., W.M.

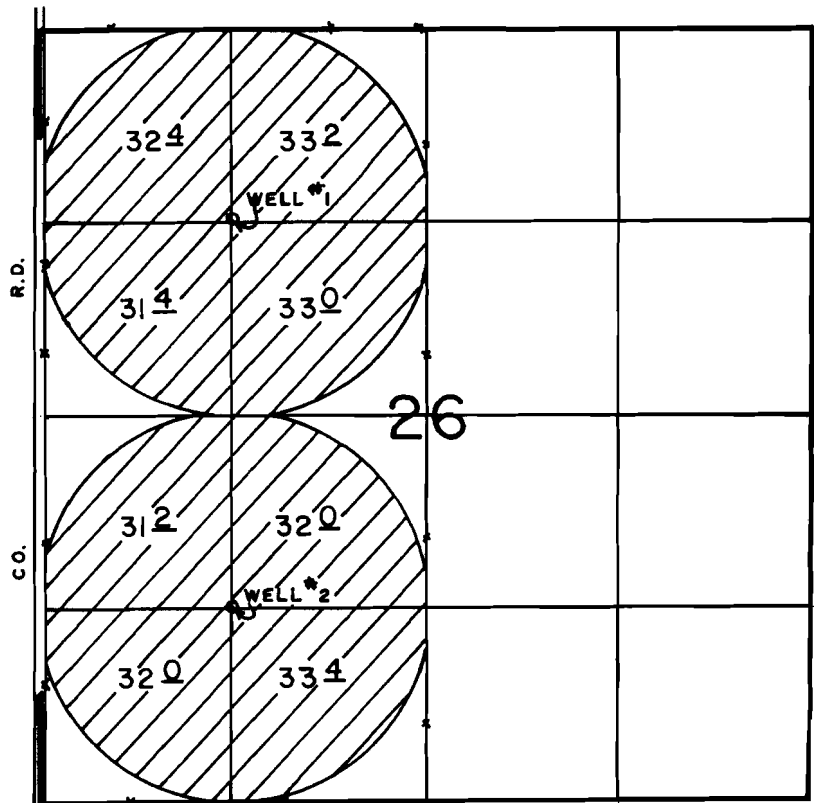

WELL 1, LOC: 1300' S. & 1320' E. FROM NW COR. OF SEC 26.

WELL 2, LOC: 1330' N. & 1330' E. FROM SW COR. OF SEC 26.

SCALE 1" = 1320'

FINAL PROOF SURVEY

UNDER

Application No. G-10214 Permit No. G-9276

IN NAME OF

FRANK, KATHLEEN, & PATRICK CORNELL

Surveyed APRIL 7, 1992, by B.W. BISHOP