


T.26S.,R.18E.,W.M.

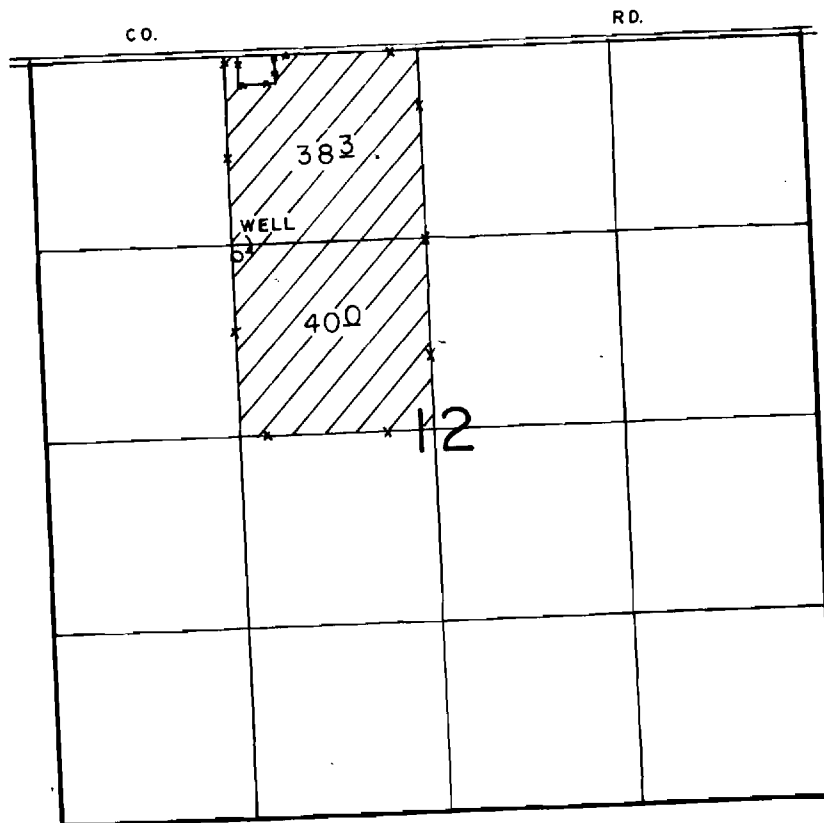

WELL LOC: 1380' S. & 1350' E. FROM NW COR. OF SEC 12.

SCALE 1"=1320'

FINAL PROOF SURVEY
UNDER

Application No. G-10425 Permit No. G-9421.....
IN NAME OF

.....WILLIE A. & LINDA S. OLSON.....

Surveyed APRIL 8, 1992, by B.W. BISHOP.....