


G-9960  
68203

# T. 36 S., R. 11 E., W.M.

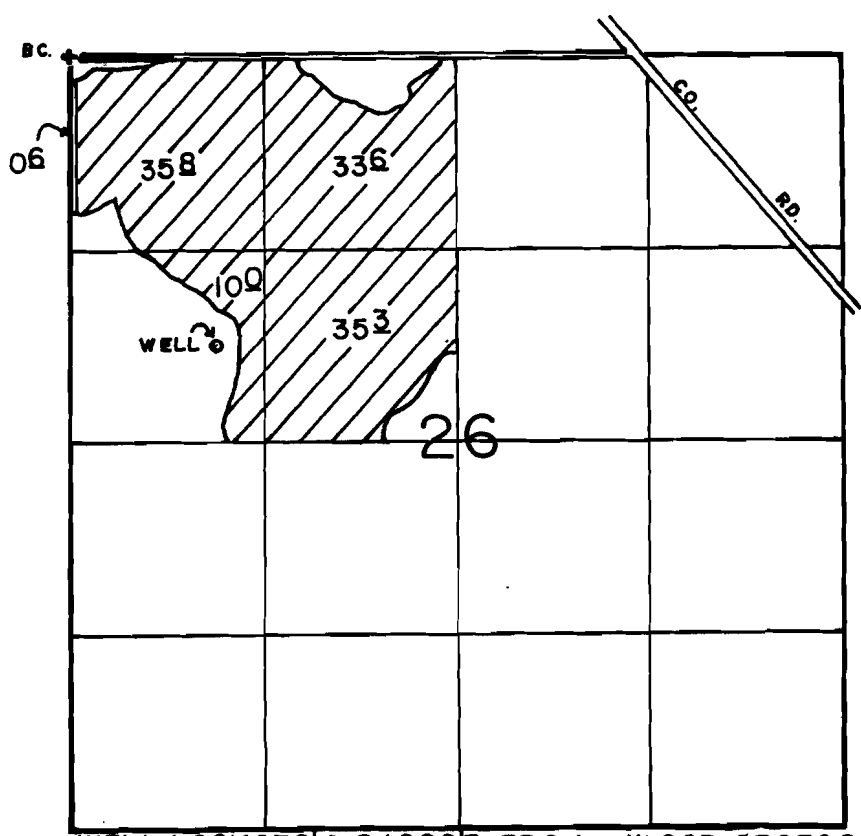

WELL LOC: 1970' S. & 1000' E. FROM NW COR. OF SEC 26.

SCALE 1" = 1320'

## FINAL PROOF SURVEY

UNDER

Application No. G-10847 Permit No. G-9960  
IN NAME OF

ROBERT W. HOFFMAN

Surveyed MAY 12, 1992, by B.W. BISHOP

Sporague & Wells