


Township 8 South, Range 2 West, W.M.

Section 4

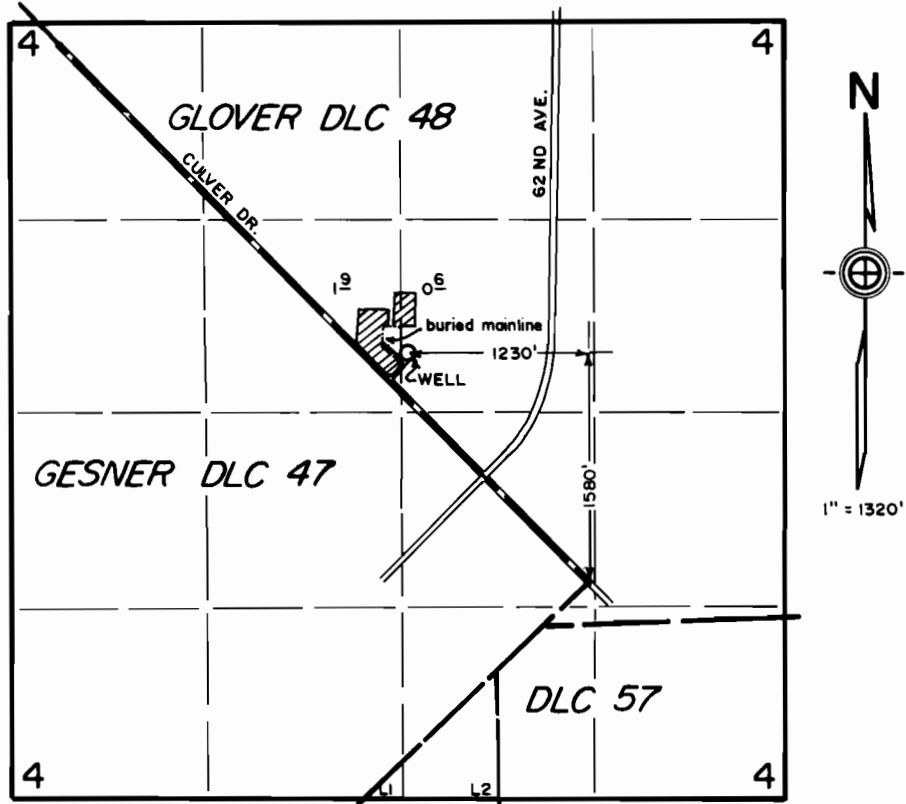

FINAL PROOF SURVEY

under

Appl. No. G-11760, Per. No. G-10859

in name of


JOHN C. ZWART

August 17, 1992

RECEIVED

AUG 21 1992


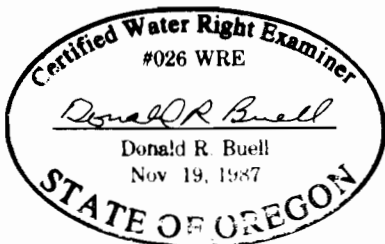

THIS MAP WAS PREPARED FOR THE PURPOSE OF IDENTIFYING THE LOCATION OF A WATER RIGHT ONLY AND IS NOT INTENDED TO PROVIDE LEGAL DIMENSIONS OR LOCATION OF PROPERTY OWNERSHIP LINES.