



# T11S, R4W, W.M.

## SECTIONS 11 & 14

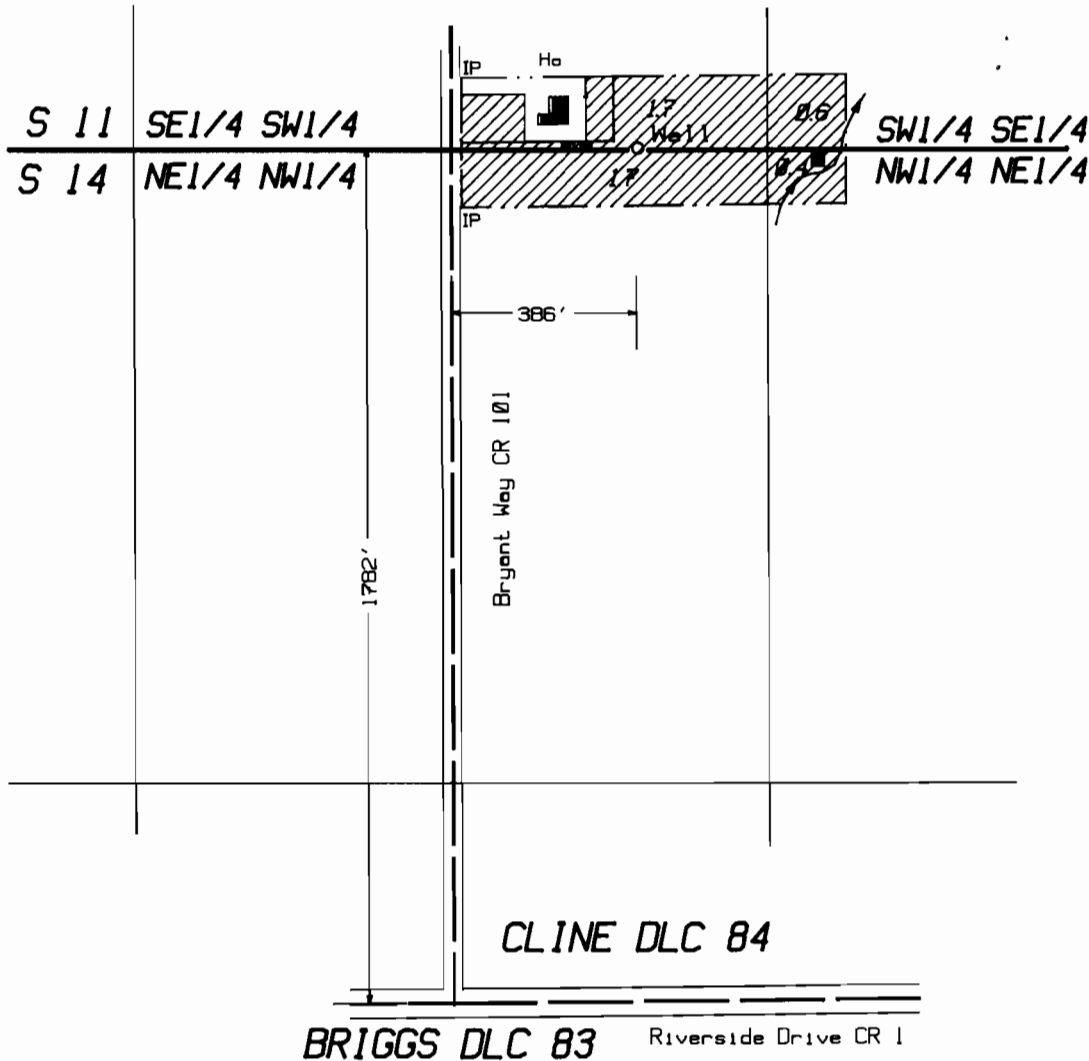

**FINAL PROOF SURVEY**  
 Application No. G-12095 Permit No. G-11101  
 IN THE NAME OF  
**PETER A. and MILDRED ROMANS**

PARSONS SURVEYING  
 1915 S.E. Stone St.  
 Corvallis, OR 97333  
 (503) 752-7515

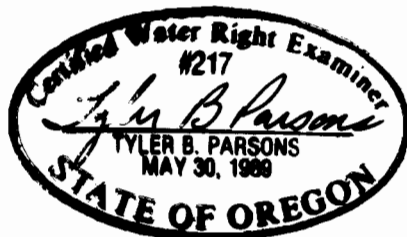

Prepared August 24, 1991

NOTE: Map is for the purpose of identifying location of water right and does not dimension or locate property ownership lines.

Proj No 9022FP