


T. 34 S., R. 5 W., W.M.

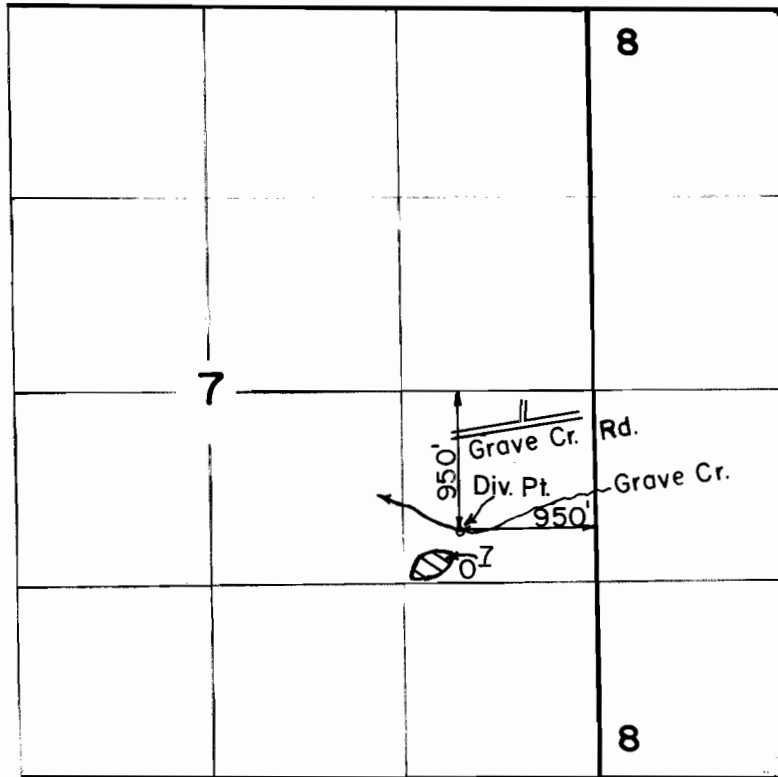

Scale: 1" = 1320'

FINAL PROOF SURVEY
UNDER

Application No. 49206 Permit No. 36885....
IN NAME OF

.....JOSEPH CHANKIN.....

Surveyed AUG...4.. 1992., by L..M..SMITH....