


T. 34 S., R. 2 W., W. M.

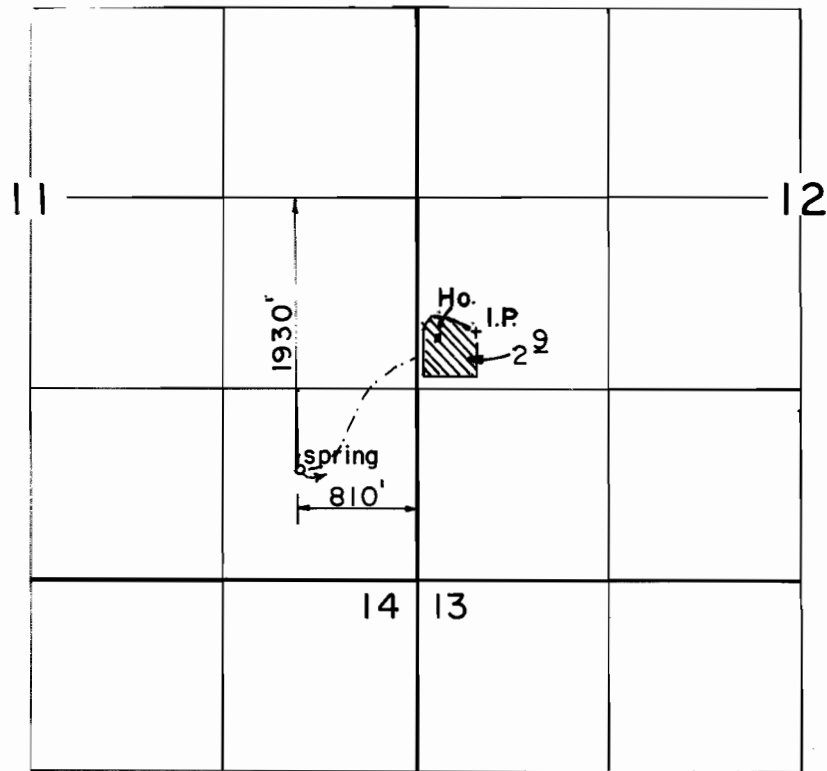

Scale: 1" = 1320'

FINAL PROOF SURVEY
UNDER

Application No. 49765 Permit No. 37.26Q...
IN NAME OF

JOHN & BRENDA CHADWICK...

Surveyed OCT. 10. 1991., by B.S. JAMES...