


See Map 9 2E 26

129-4

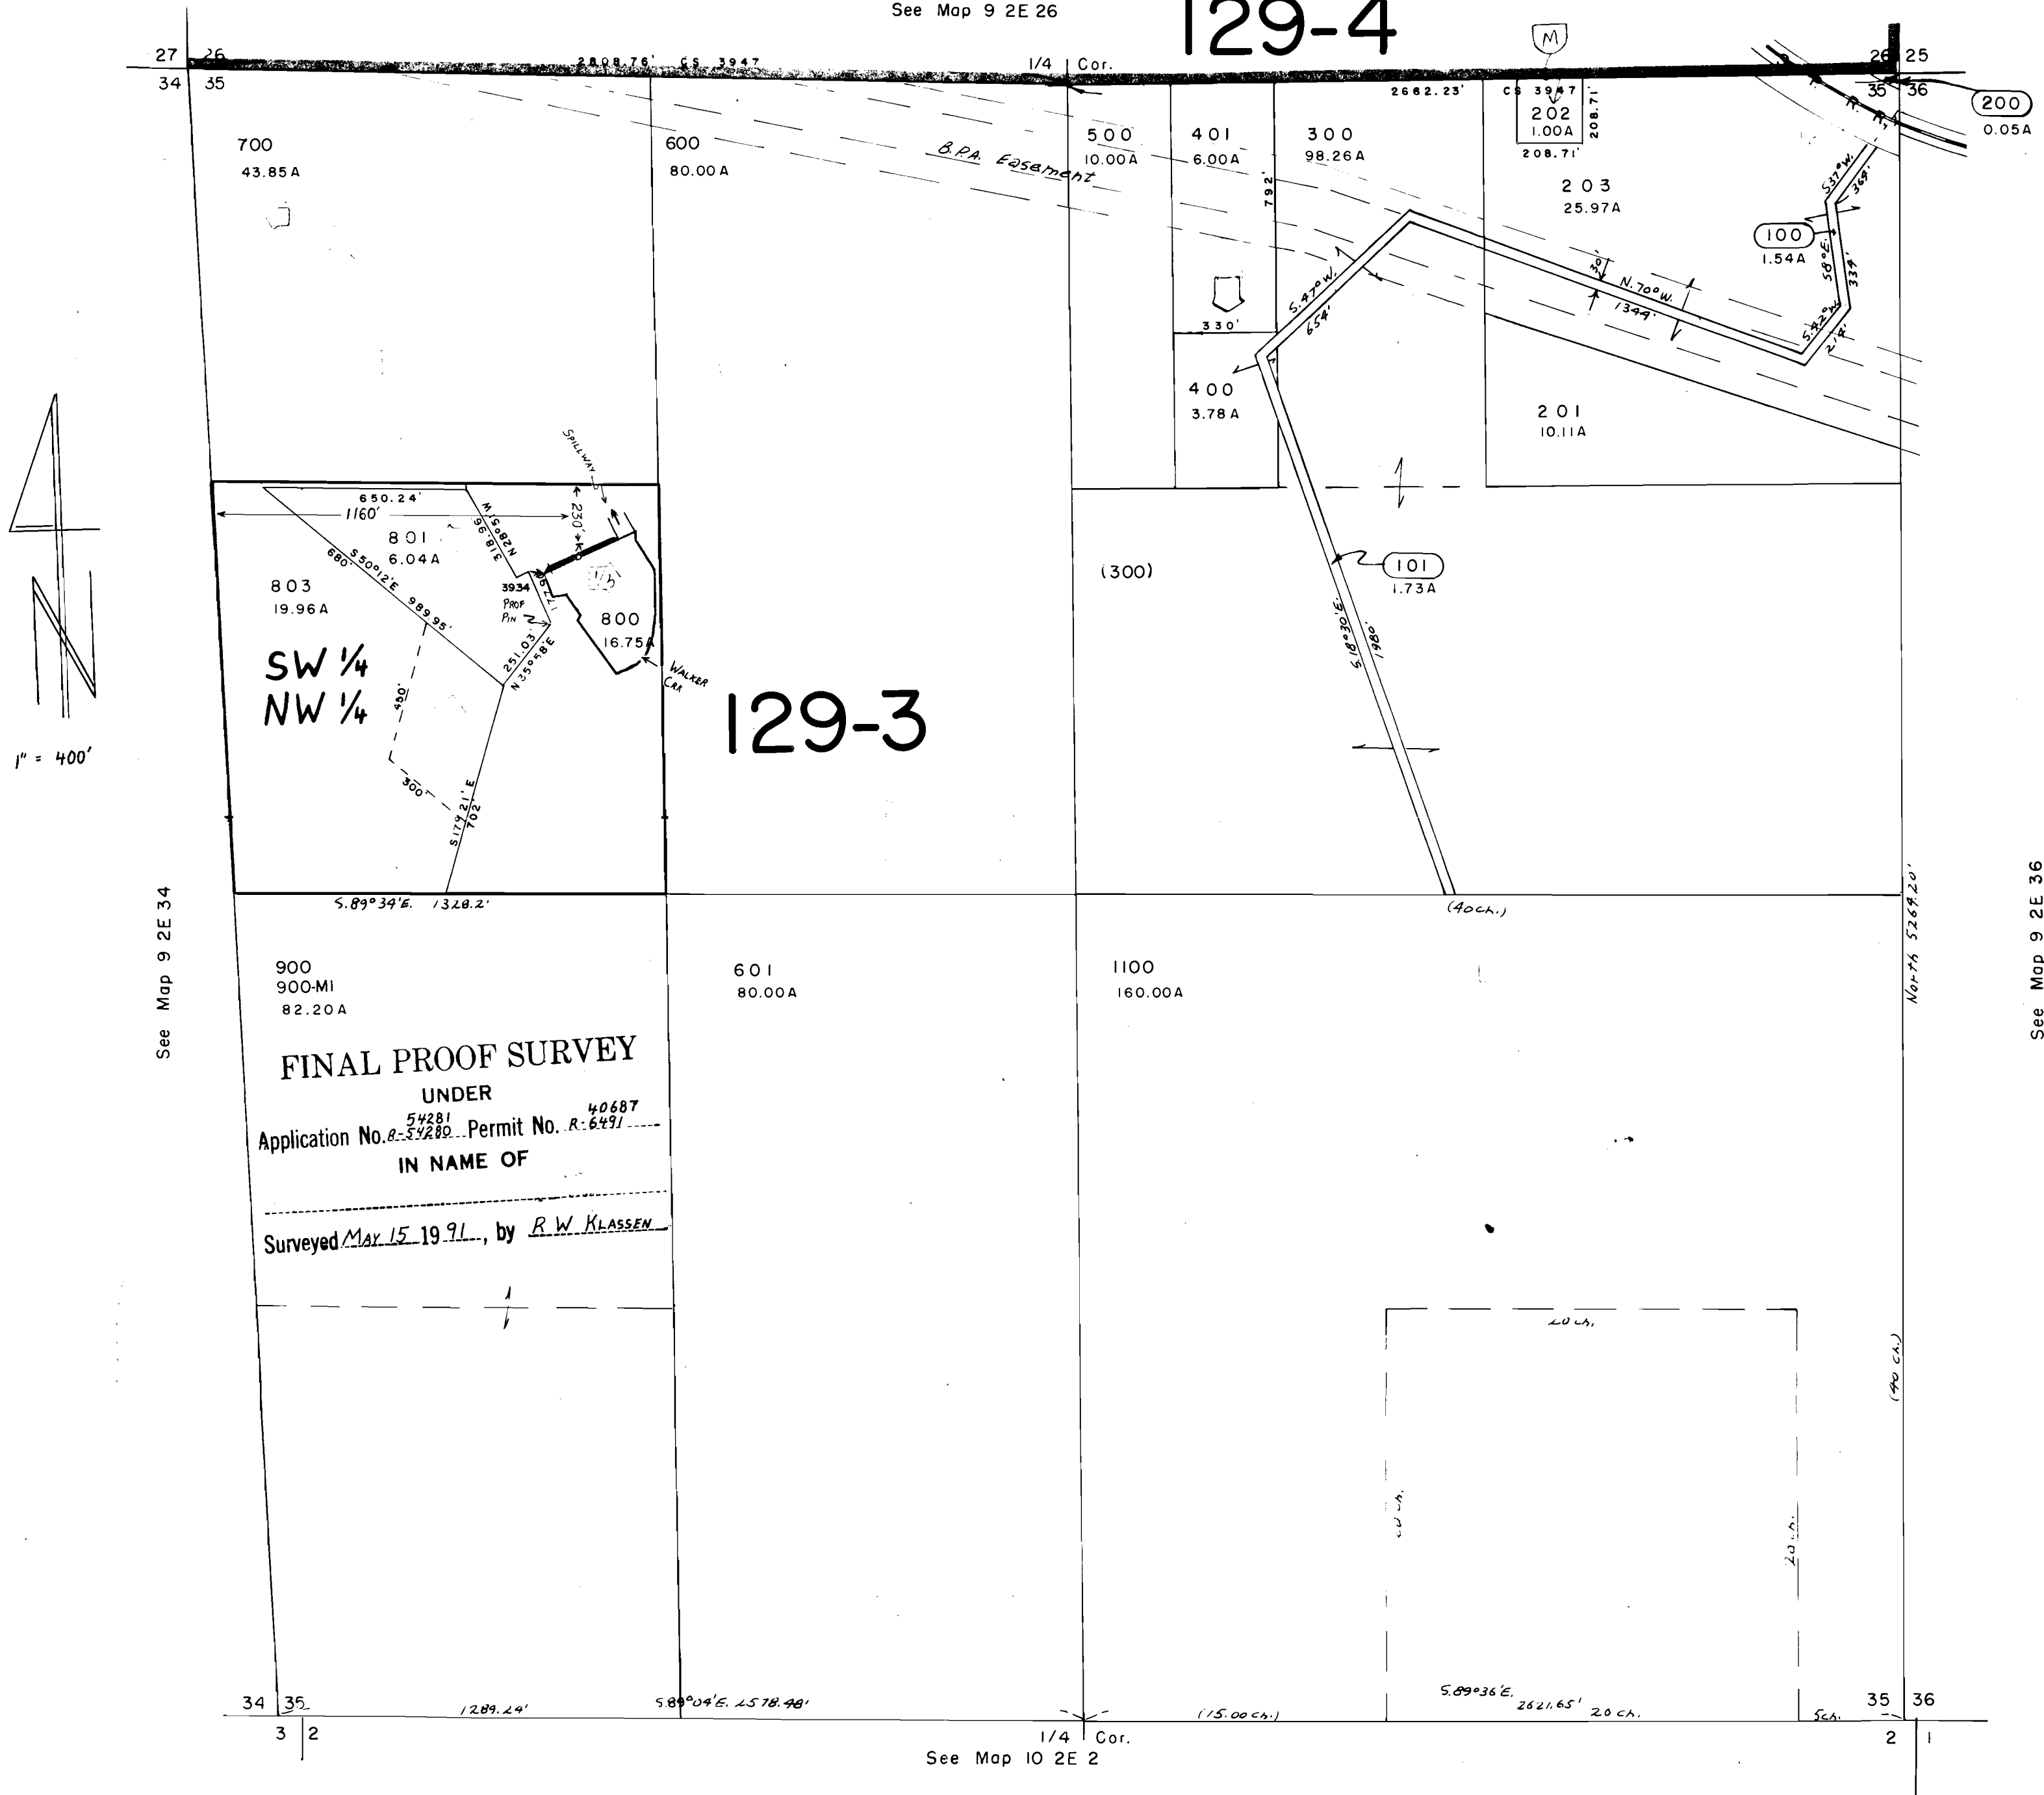

See Map, 9 2E 36