


T. 28 S., R. 7 W., W. M.

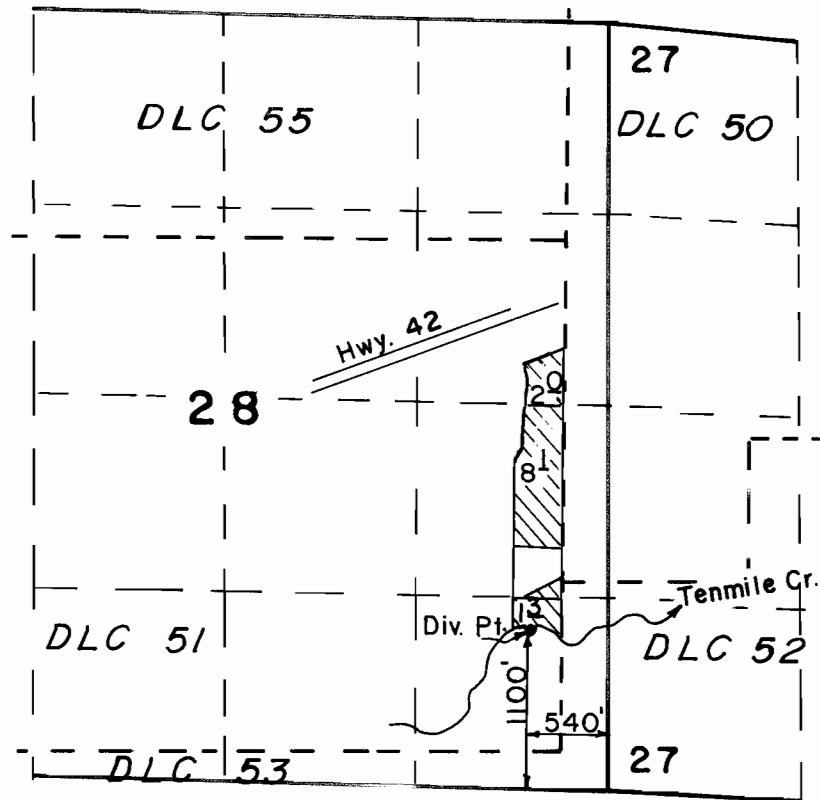

Scale: 1" = 1320'

FINAL PROOF SURVEY
UNDER

Application No. ~~55590~~ Permit No. ~~41659~~...
IN NAME OF

.....WILLA MAE TEEL.....

Surveyed AUG. 29 1990, by B. S. JAMES....