


1" = 400'

NW Cor
Timothy A. Riggs
DLC 39

See Map 14 1W 7

T 14 S R 1 W

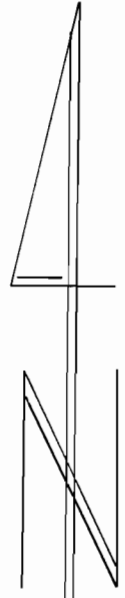

1" = 400'


FINAL PROOF SURVEY

UNDER
Application No. 58323 Permit No. 47092

IN NAME OF

LEE ANDREW & DOROTHY DOLORIS AMERS

Surveyed MAY 13, 1991, by R. W. KLASSEN

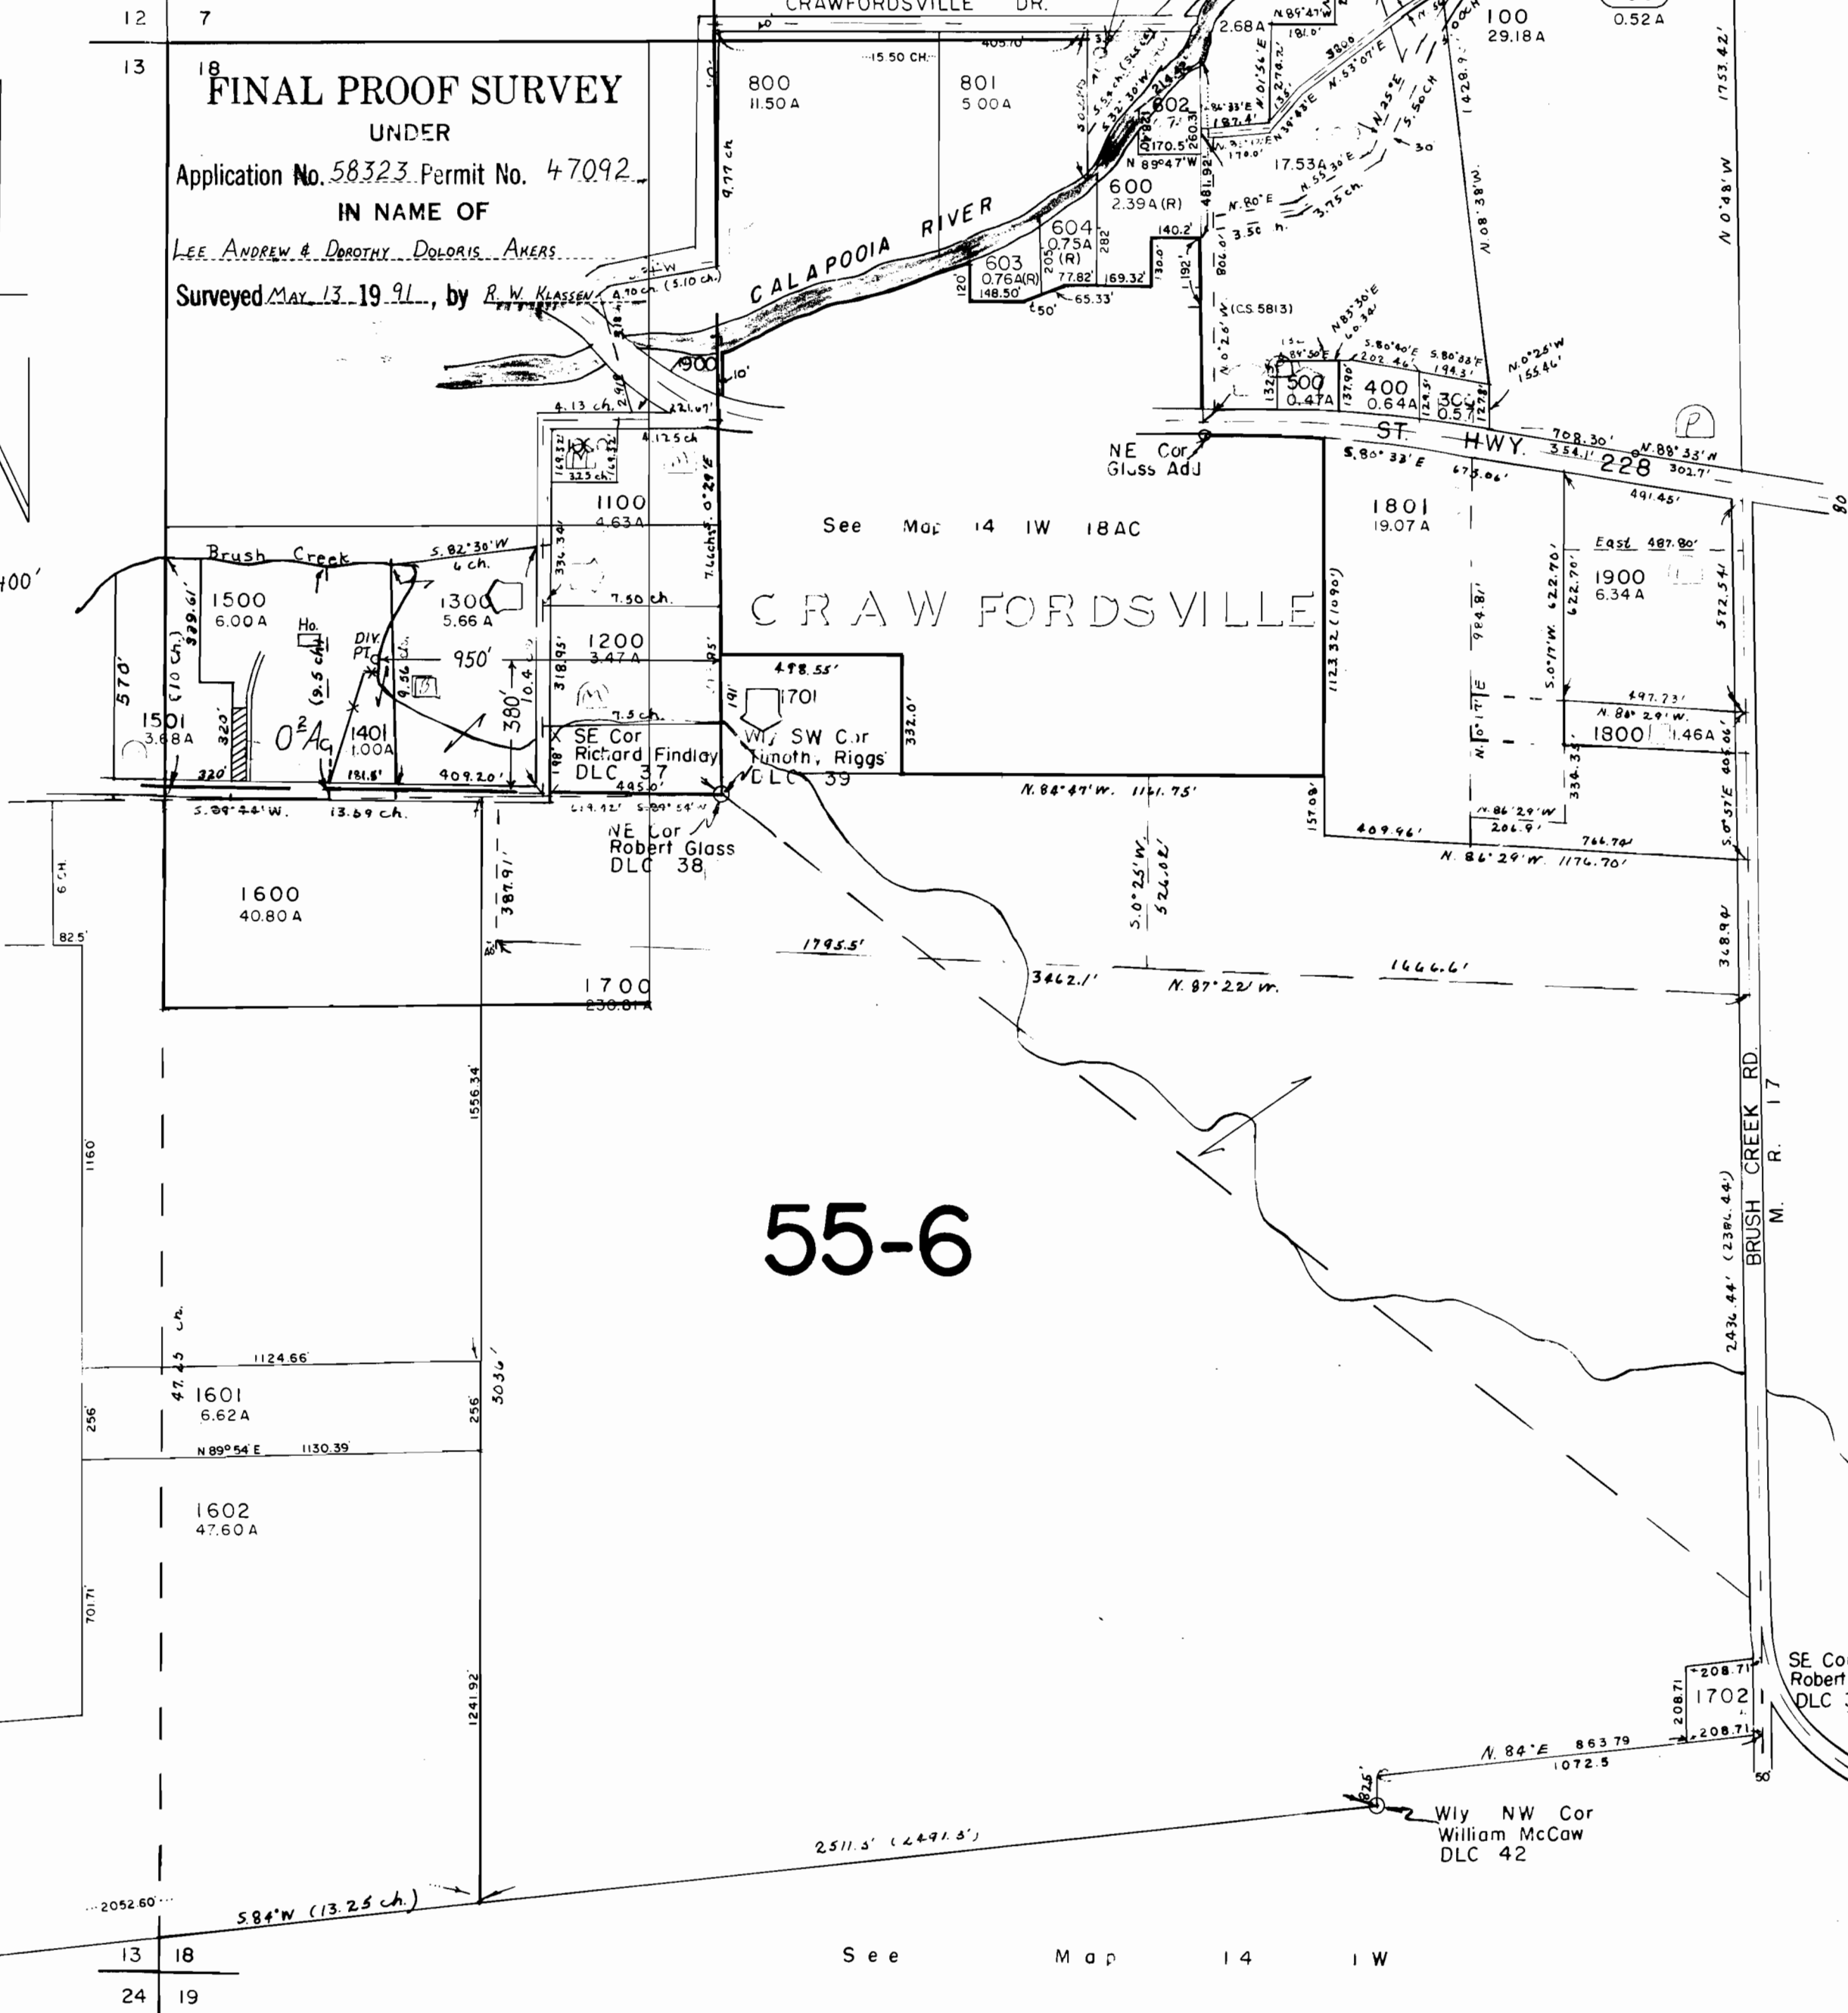

55-6

See Map 14 1W

7 8
18 17

See Map 14 1W 17

18 17
19 20