


T. 34 S., R. 2 W., W.M.

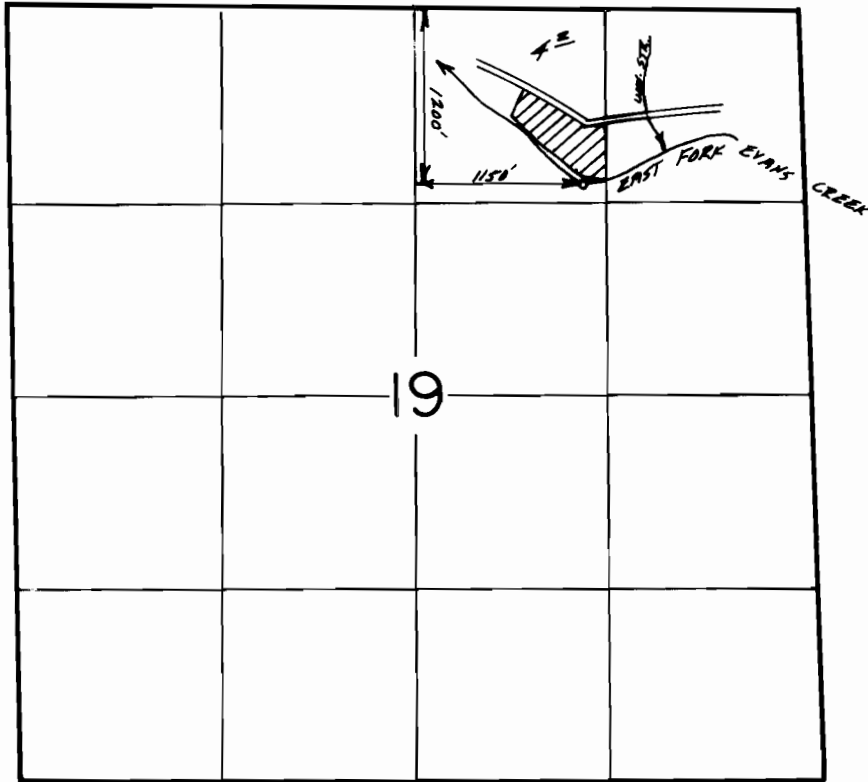

Scale 1" = 1320'

**FINAL PROOF SURVEY**  
UNDER

Application No. ~~58664~~ Permit No. ~~44283~~...  
IN NAME OF

.....CHARLES E. STONE.....

Surveyed July 24, 1992, by S. James.....