


T. 27 S., R. 12 W., W. M.

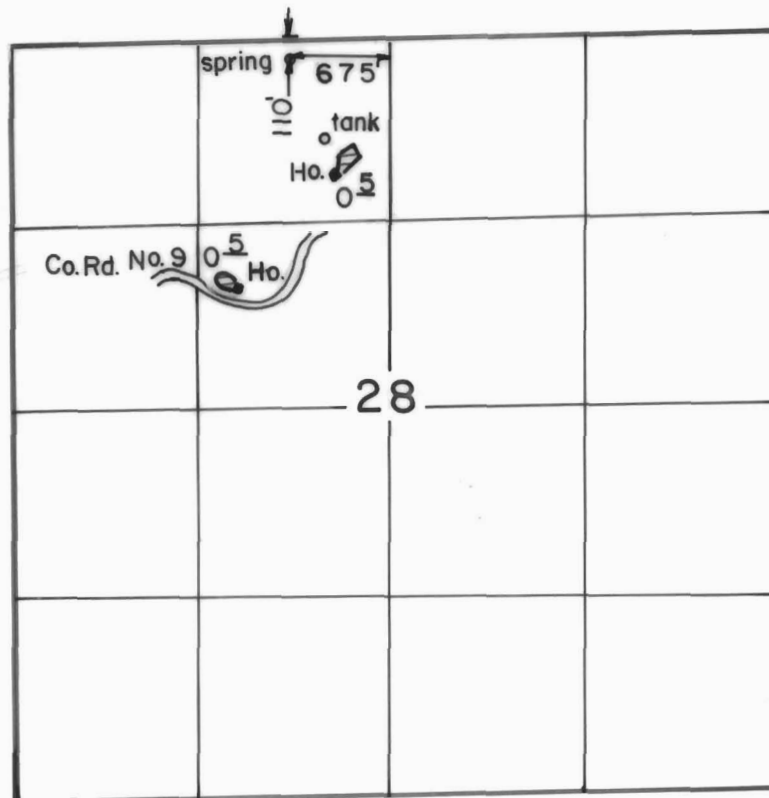

FINAL PROOF SURVEY
UNDER

Application No. 59492 Permit No. 45443..
IN NAME OF

.....
Surveyed JULY.21 1992., by L.M..SMITH.....