


T.40S., R.13W., W.M.

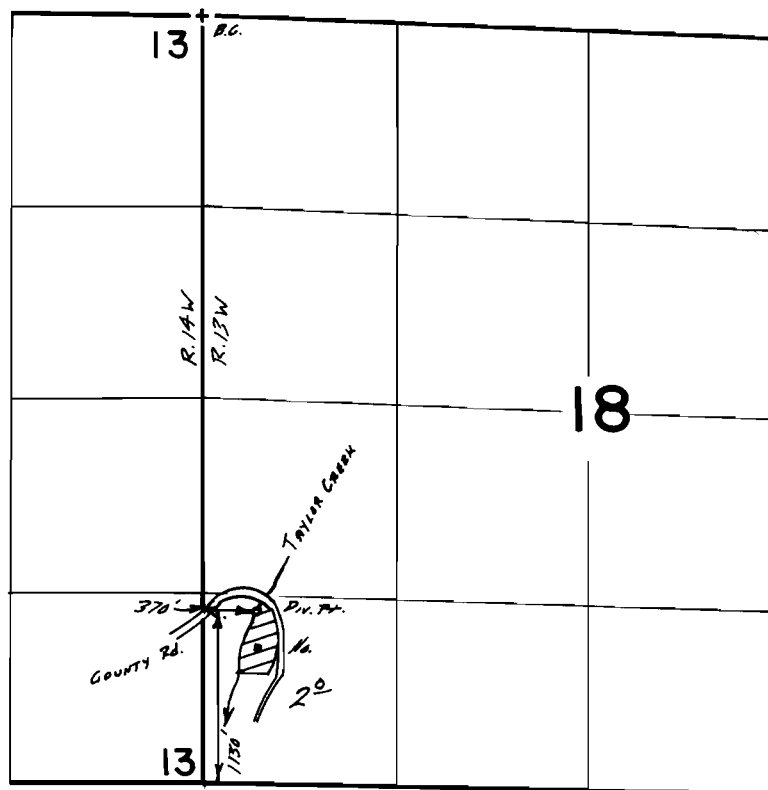

Scale 1"=1320'

FINAL PROOF SURVEY UNDER

Application No. 60151... Permit No. 46066...
IN NAME OF

WILLIAM R. & MICHELLE A. R. ROSS

Surveyed April 9, 1992, by B.S. James.....