


T.28S., R.6W., W.M.

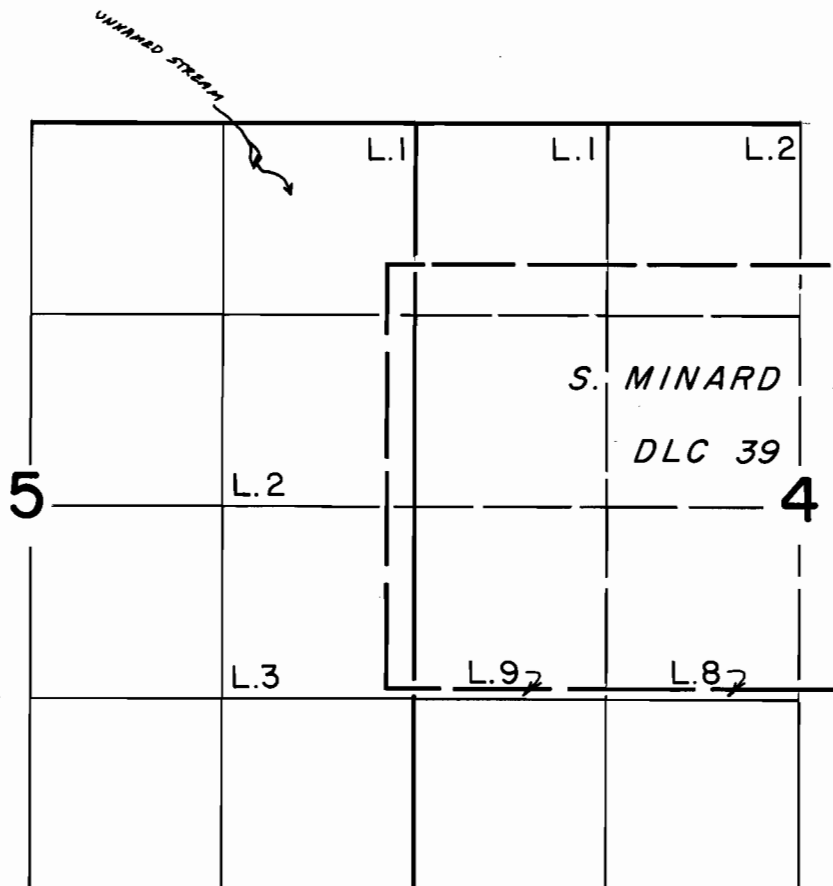

Scale 1" = 1320'



FINAL PROOF SURVEY UNDER

Application No. R-61184 Permit No. R-8388...
IN NAME OF

.....
Surveyed Aug. 2, 1990, by B.S. JAMES.....