


T. 28 S., R. 7 W., W. M.

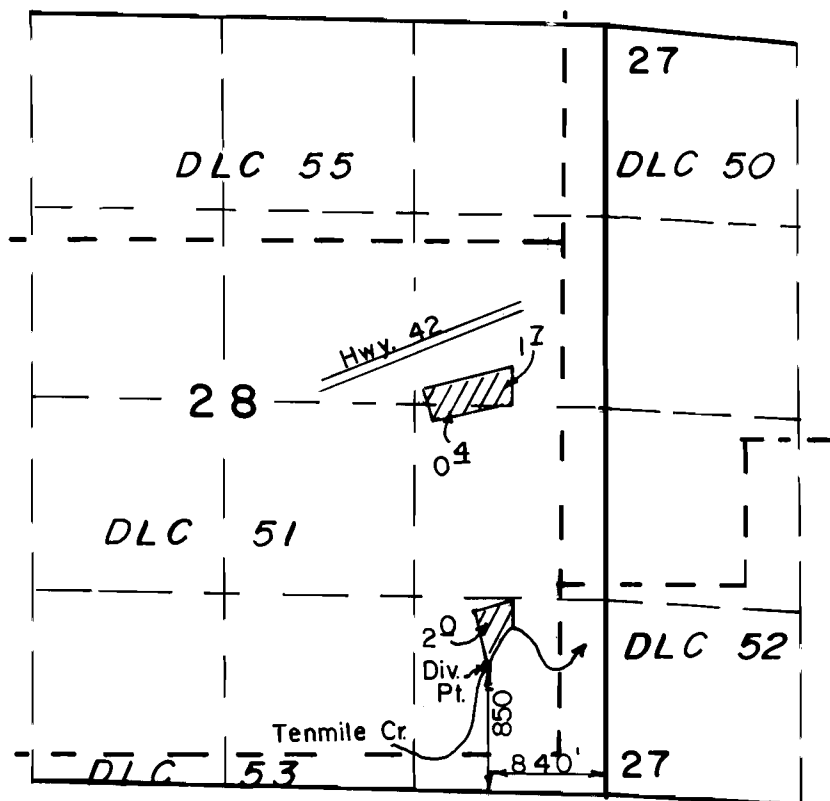

Scale: 1" = 1320'

**FINAL PROOF SURVEY
UNDER**

Application No. 61410 Permit No. 46032.
IN NAME OF

MAPLE LEAF FARMING CORP.

Surveyed AUG. 29 1990, by B. S. JAMES.