NW 1/4 SEC. 10 T.2S. R.9W.W.M.
TILLAMOOK COUNTY
1" = 200'

2S 9 10B

This map was prepared for assessment purpose only.
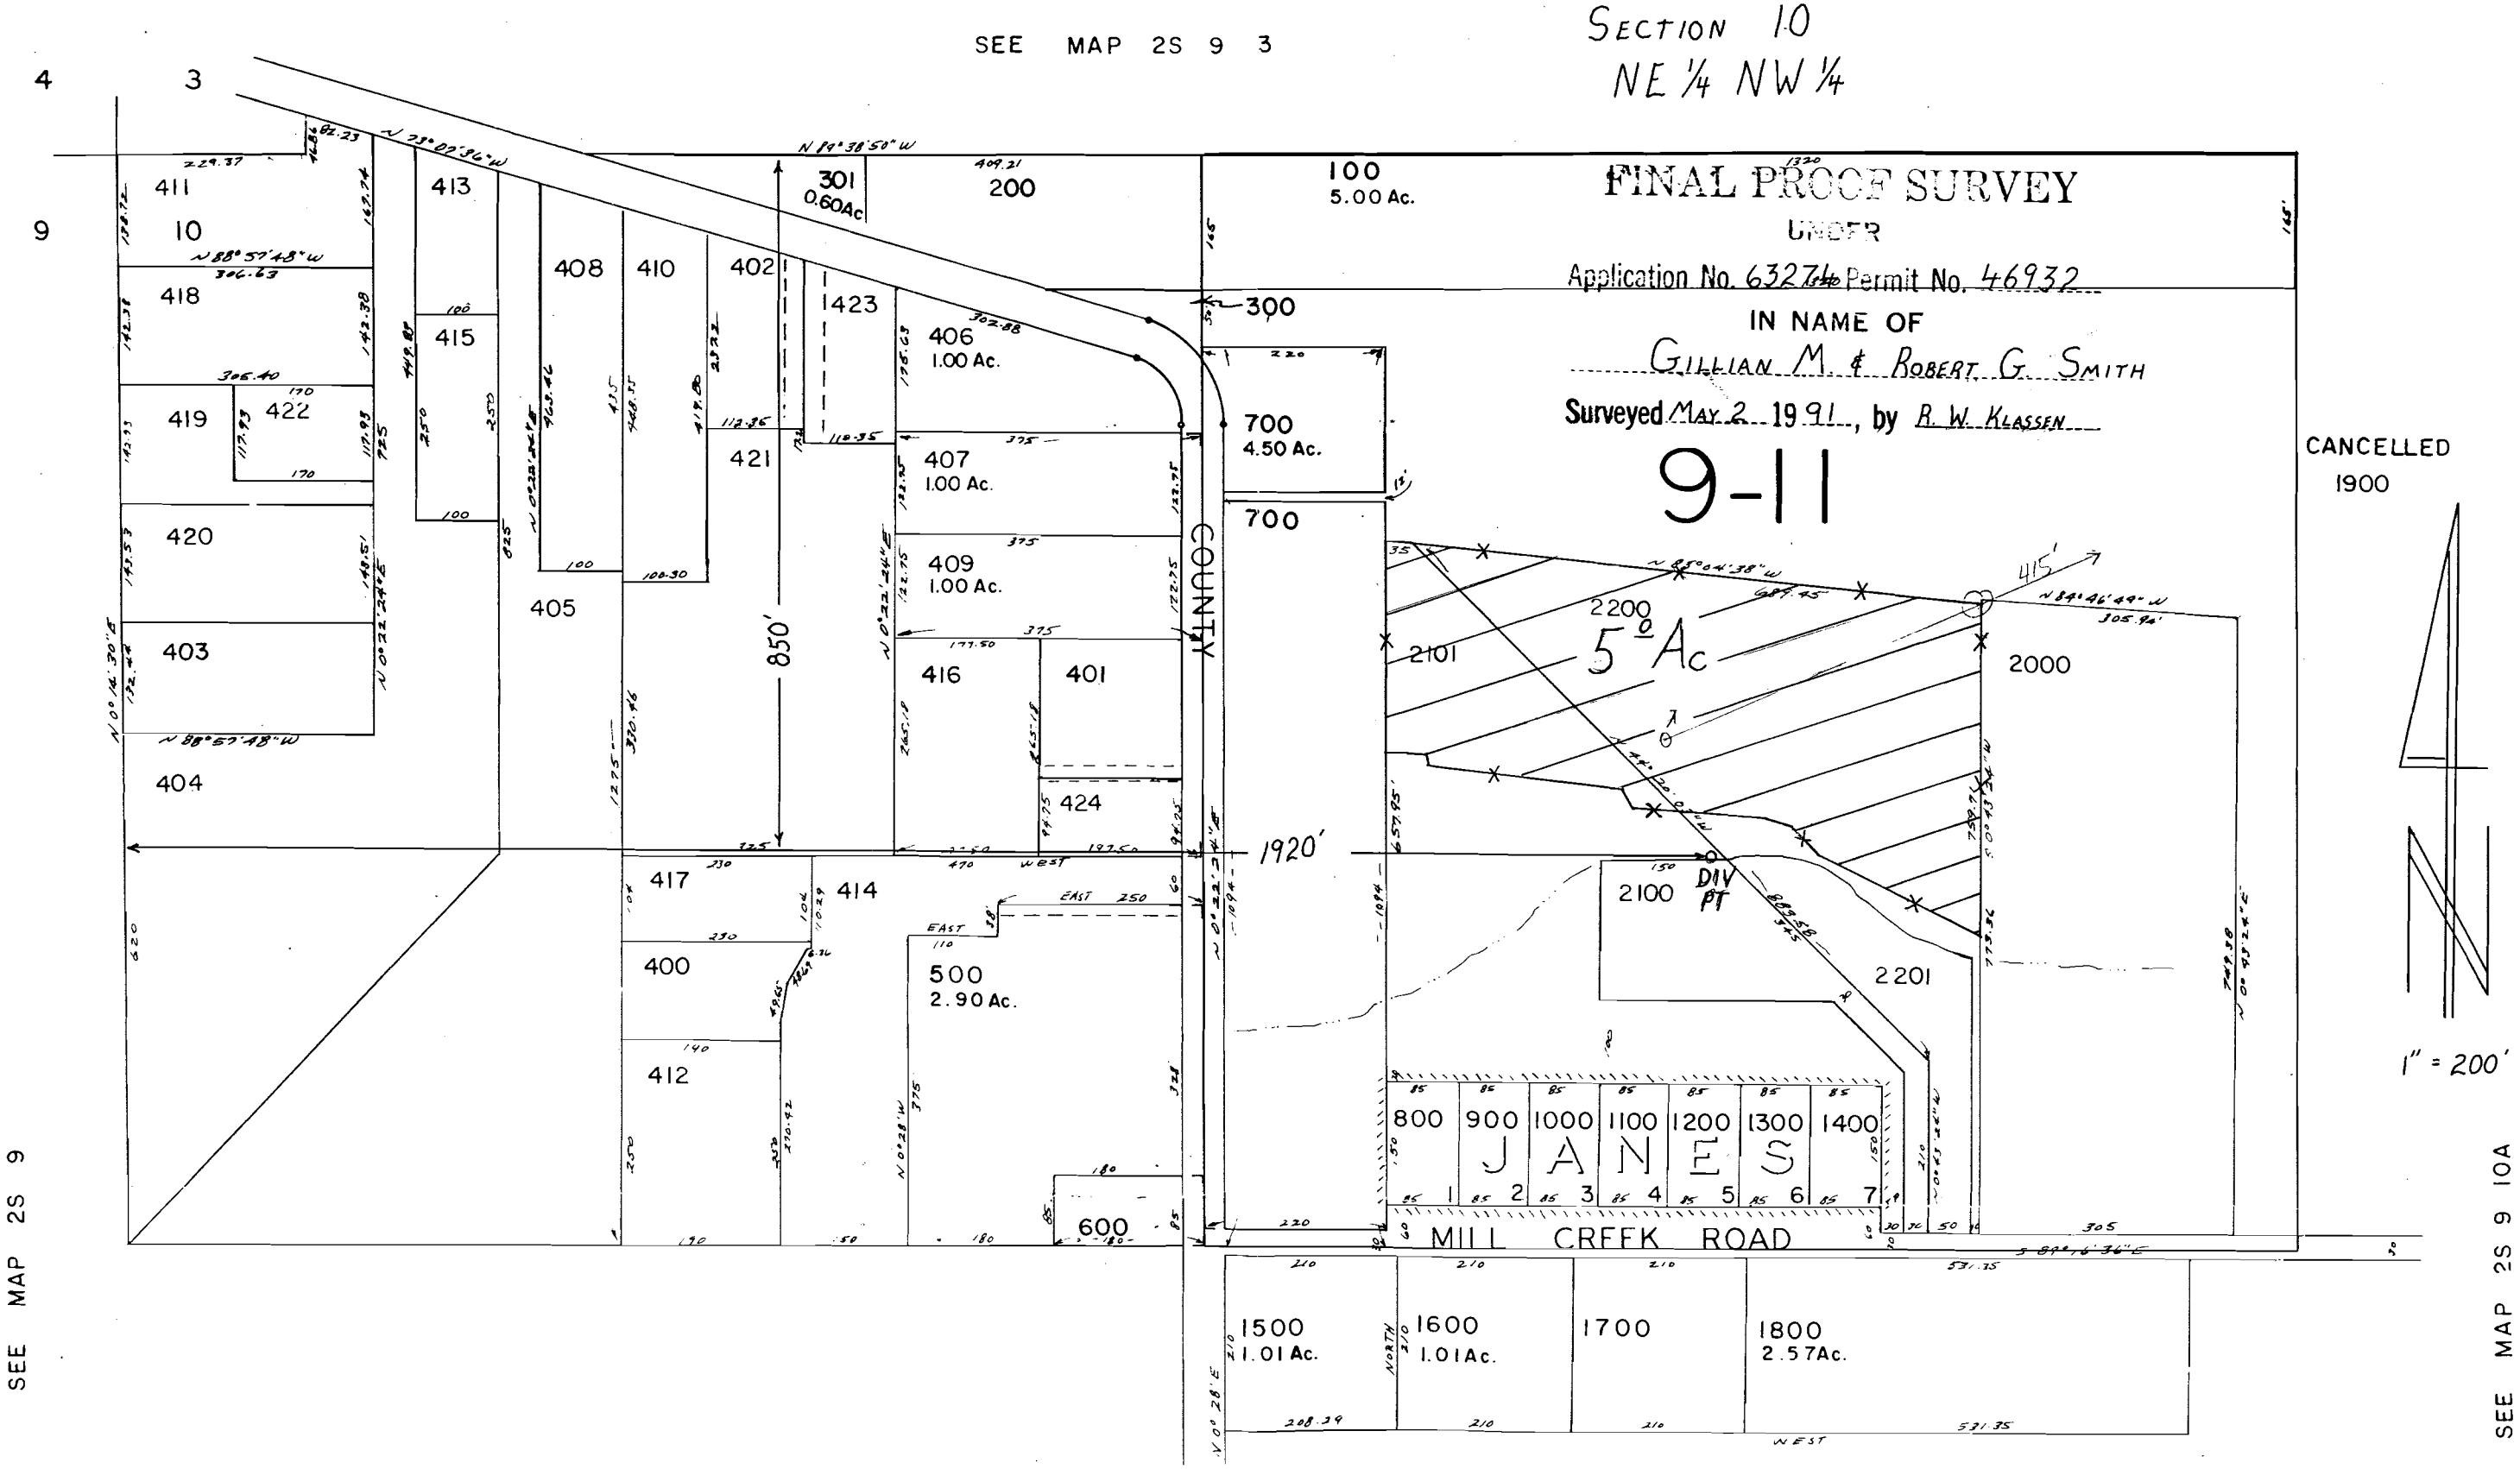
T 2S R 9W
SECTION 10
NE 1/4 NW 1/4