


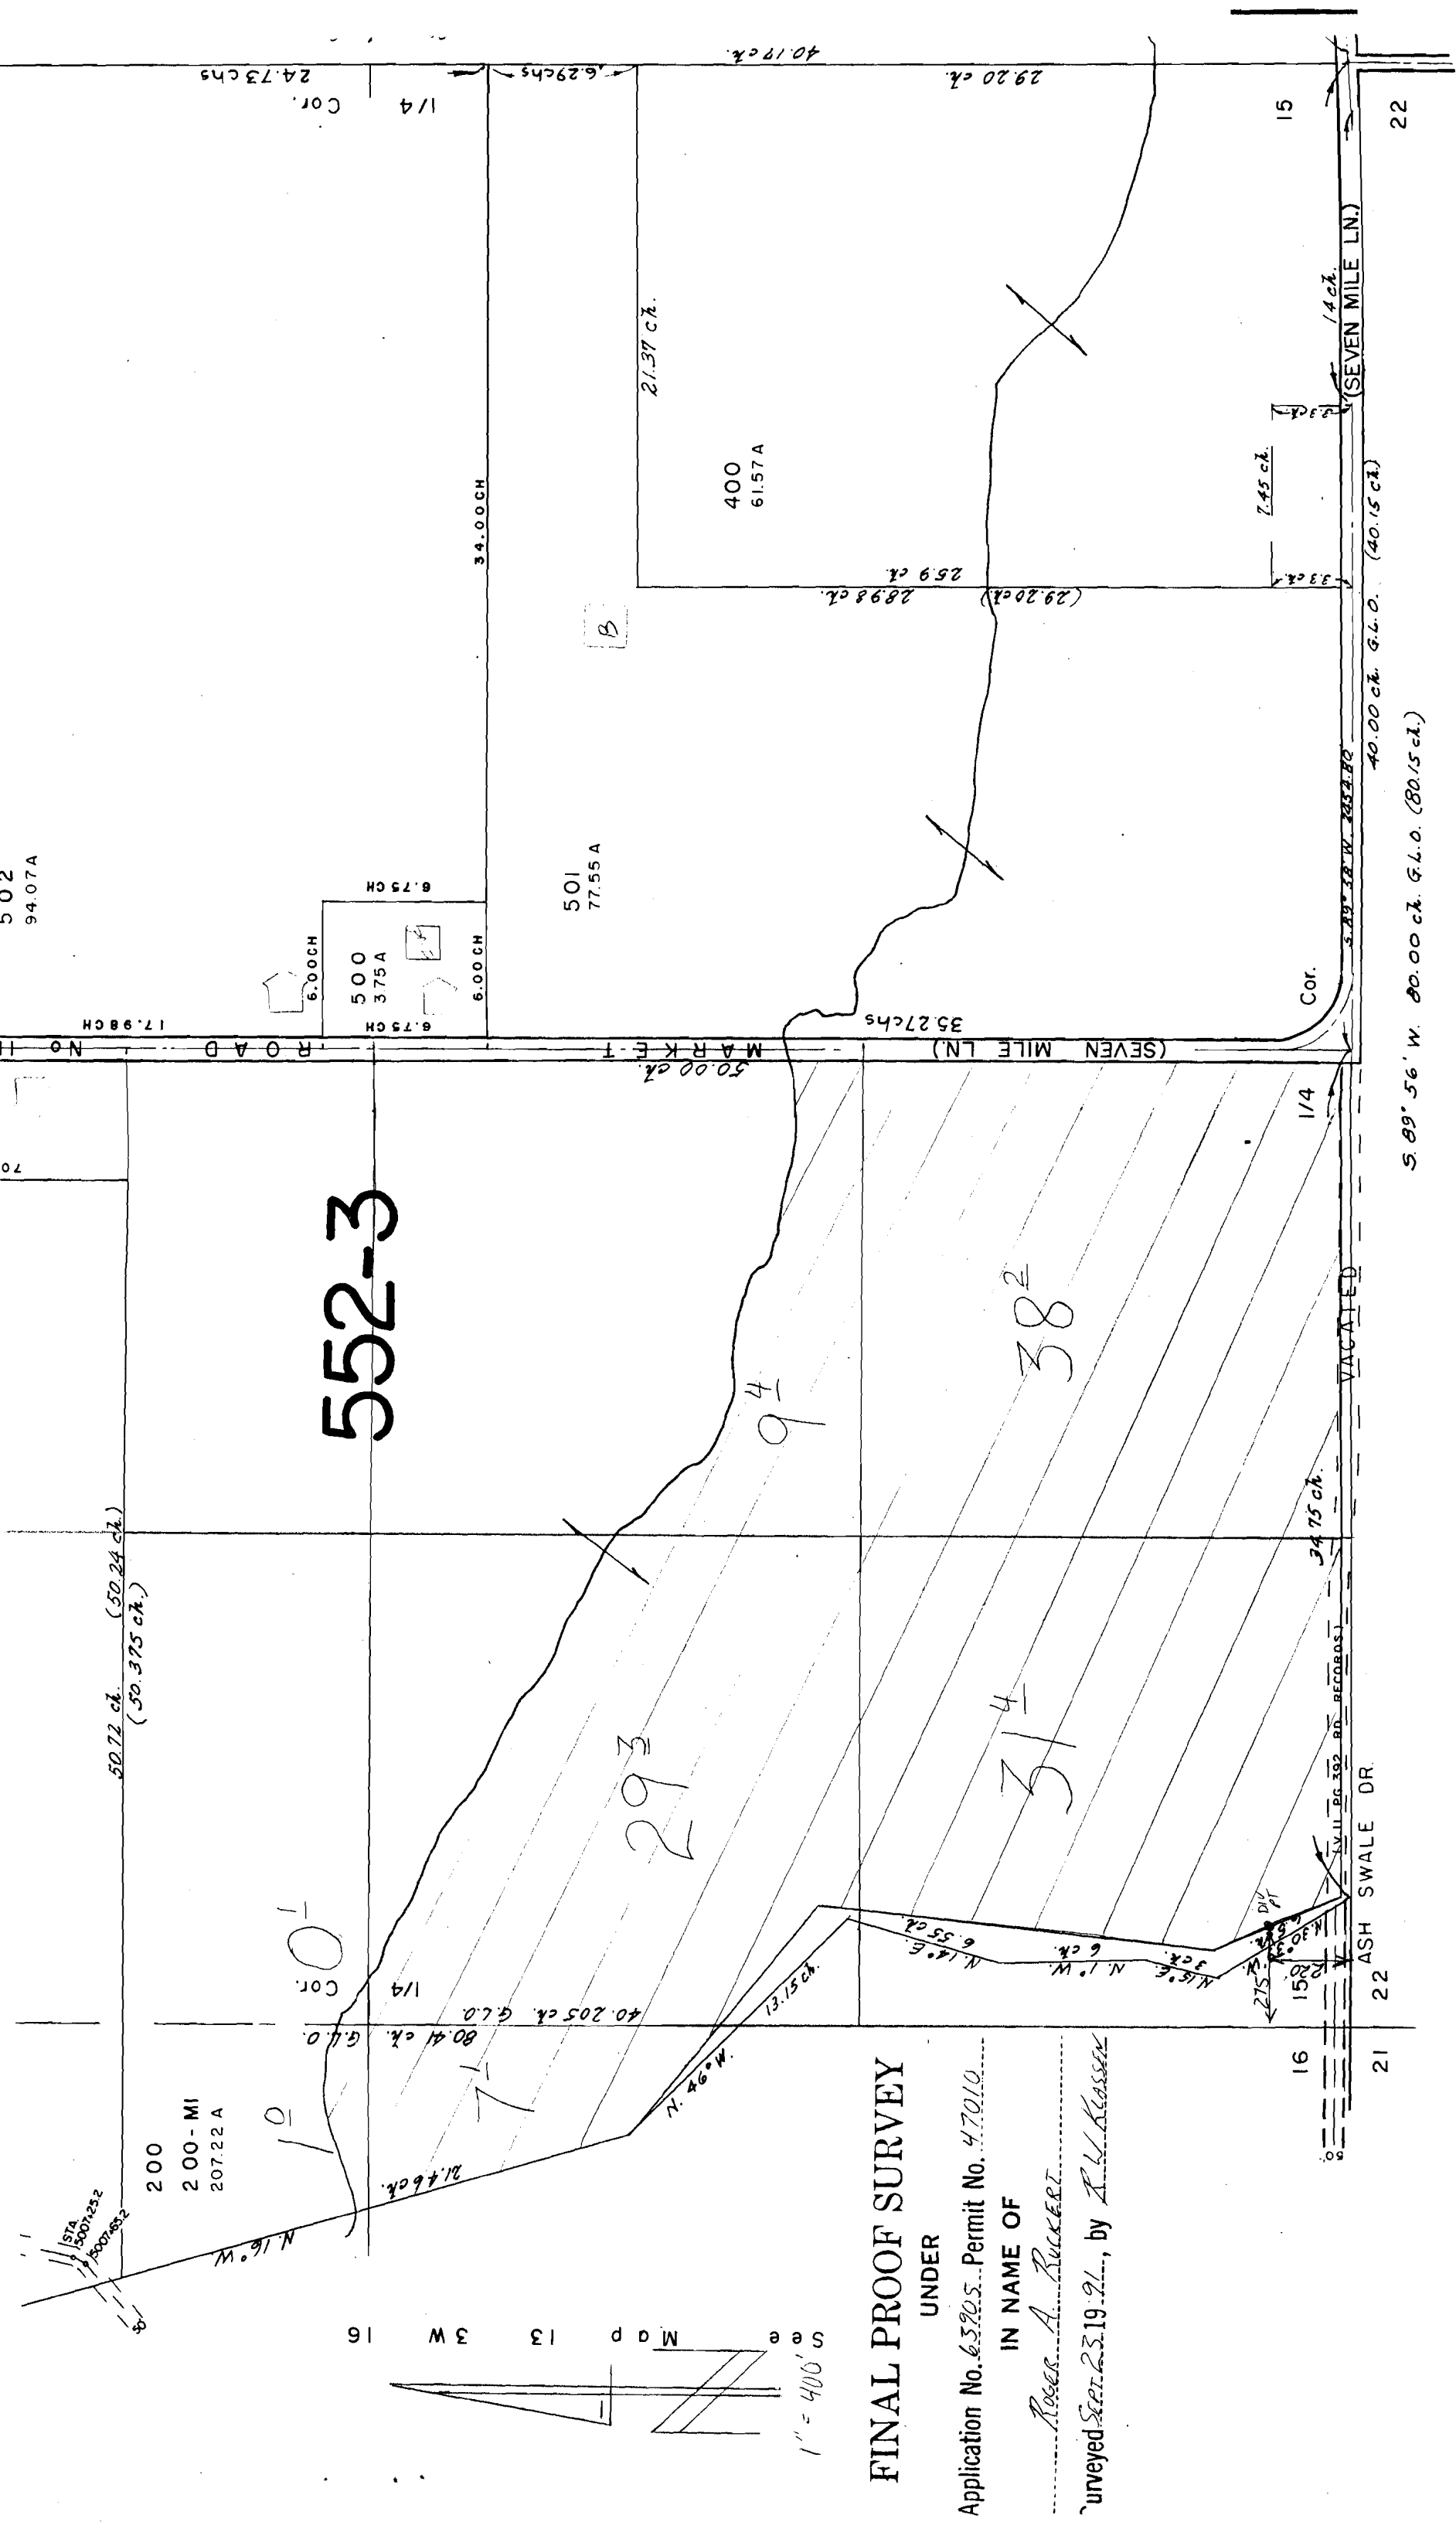

FINAL PROOF SURVEY

UNDER

Application No. 63905 Permit No. 47010

IN NAME OF

Roger A. Ruckert

Surveyed Sept. 23, 1991, by R. W. Klassen

