


T. 25 S., R. 6 & 7 W., W. M.

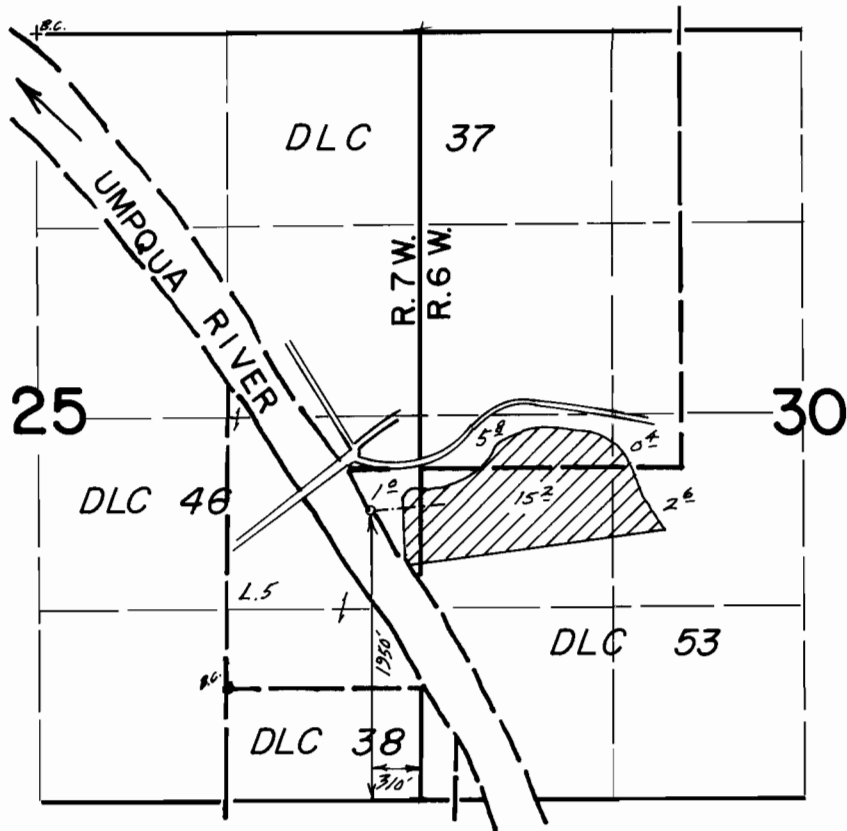

Scale 1" = 1320'

FINAL PROOF SURVEY
UNDER

Application No. 65048 Permit No. 47.789....
IN NAME OF

.....TODD.....HARTMAN.....

Surveyed Oct. 21. 1991., by L. Joachims...