


T. 33 S., R. 6 W., W. M.

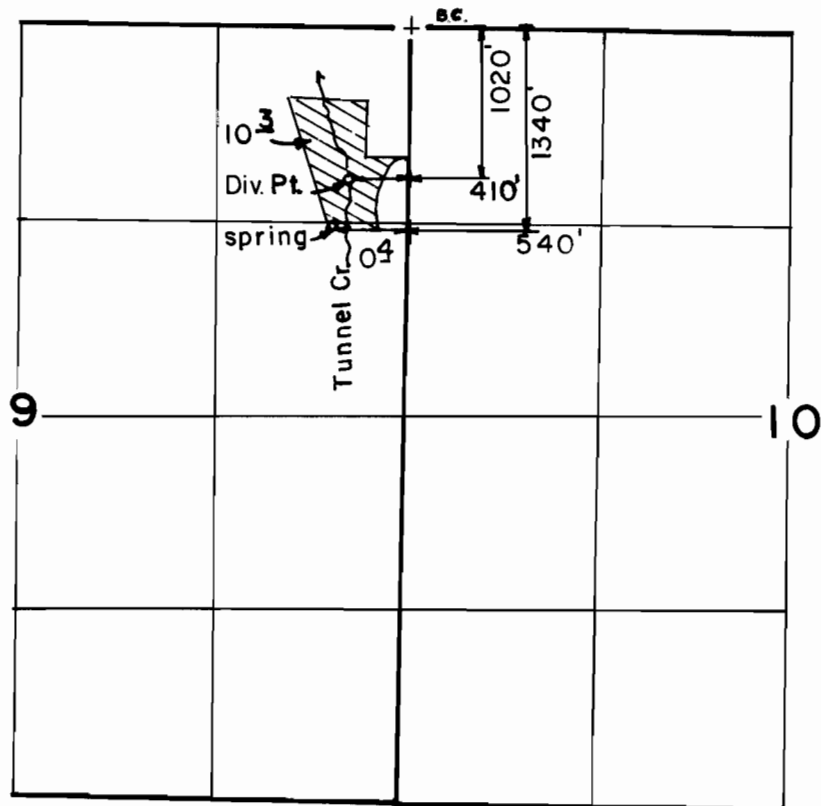

Scale: 1" = 1320'

FINAL PROOF SURVEY
UNDER

Application No. 65193 Permit No. 48199....
IN NAME OF

.....KAREL & HERTA VITU.....

Surveyed JULY 12, 1990, by B.S. JAMES...