


T. 20S., R. 10W., W.M.

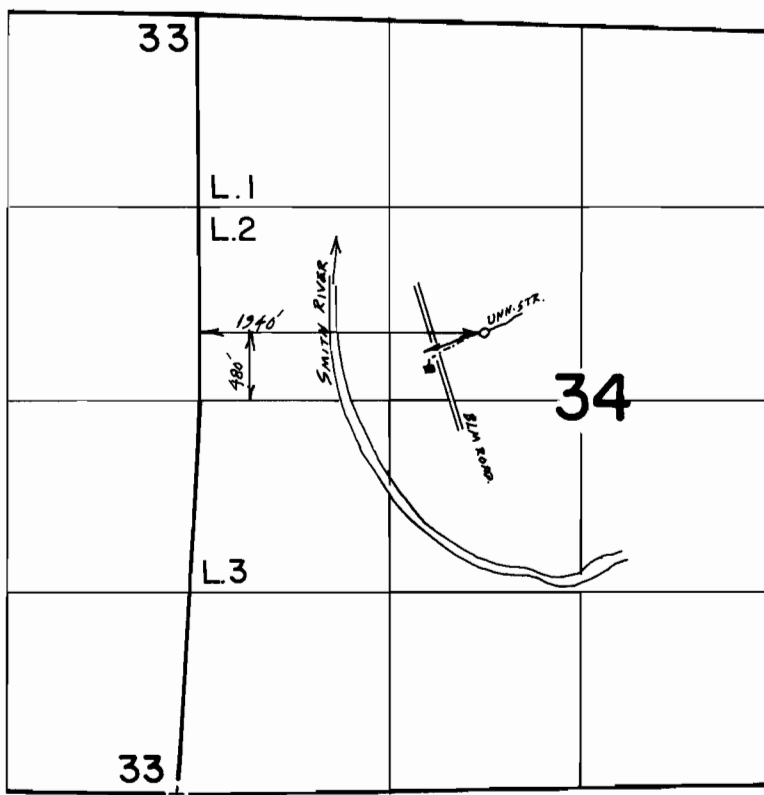

Scale 1" = 1320'

**FINAL PROOF SURVEY
UNDER**

Application No. 65294 Permit No. 47917.....
IN NAME OF

PAUL M. & MARCELLA DAILEY

Surveyed Sept. 3, 1992., by S. James.....