

1" = 200'

FINAL PROOF SURVEY

UNDER

Application No. 65337 Permit No. 47940


9-1

IN NAME OF

JUDITH FLORENCE BLACKWOOD

Surveyed APRIL 29 1991, by R W KLASSEN

SEE MAP IS 8

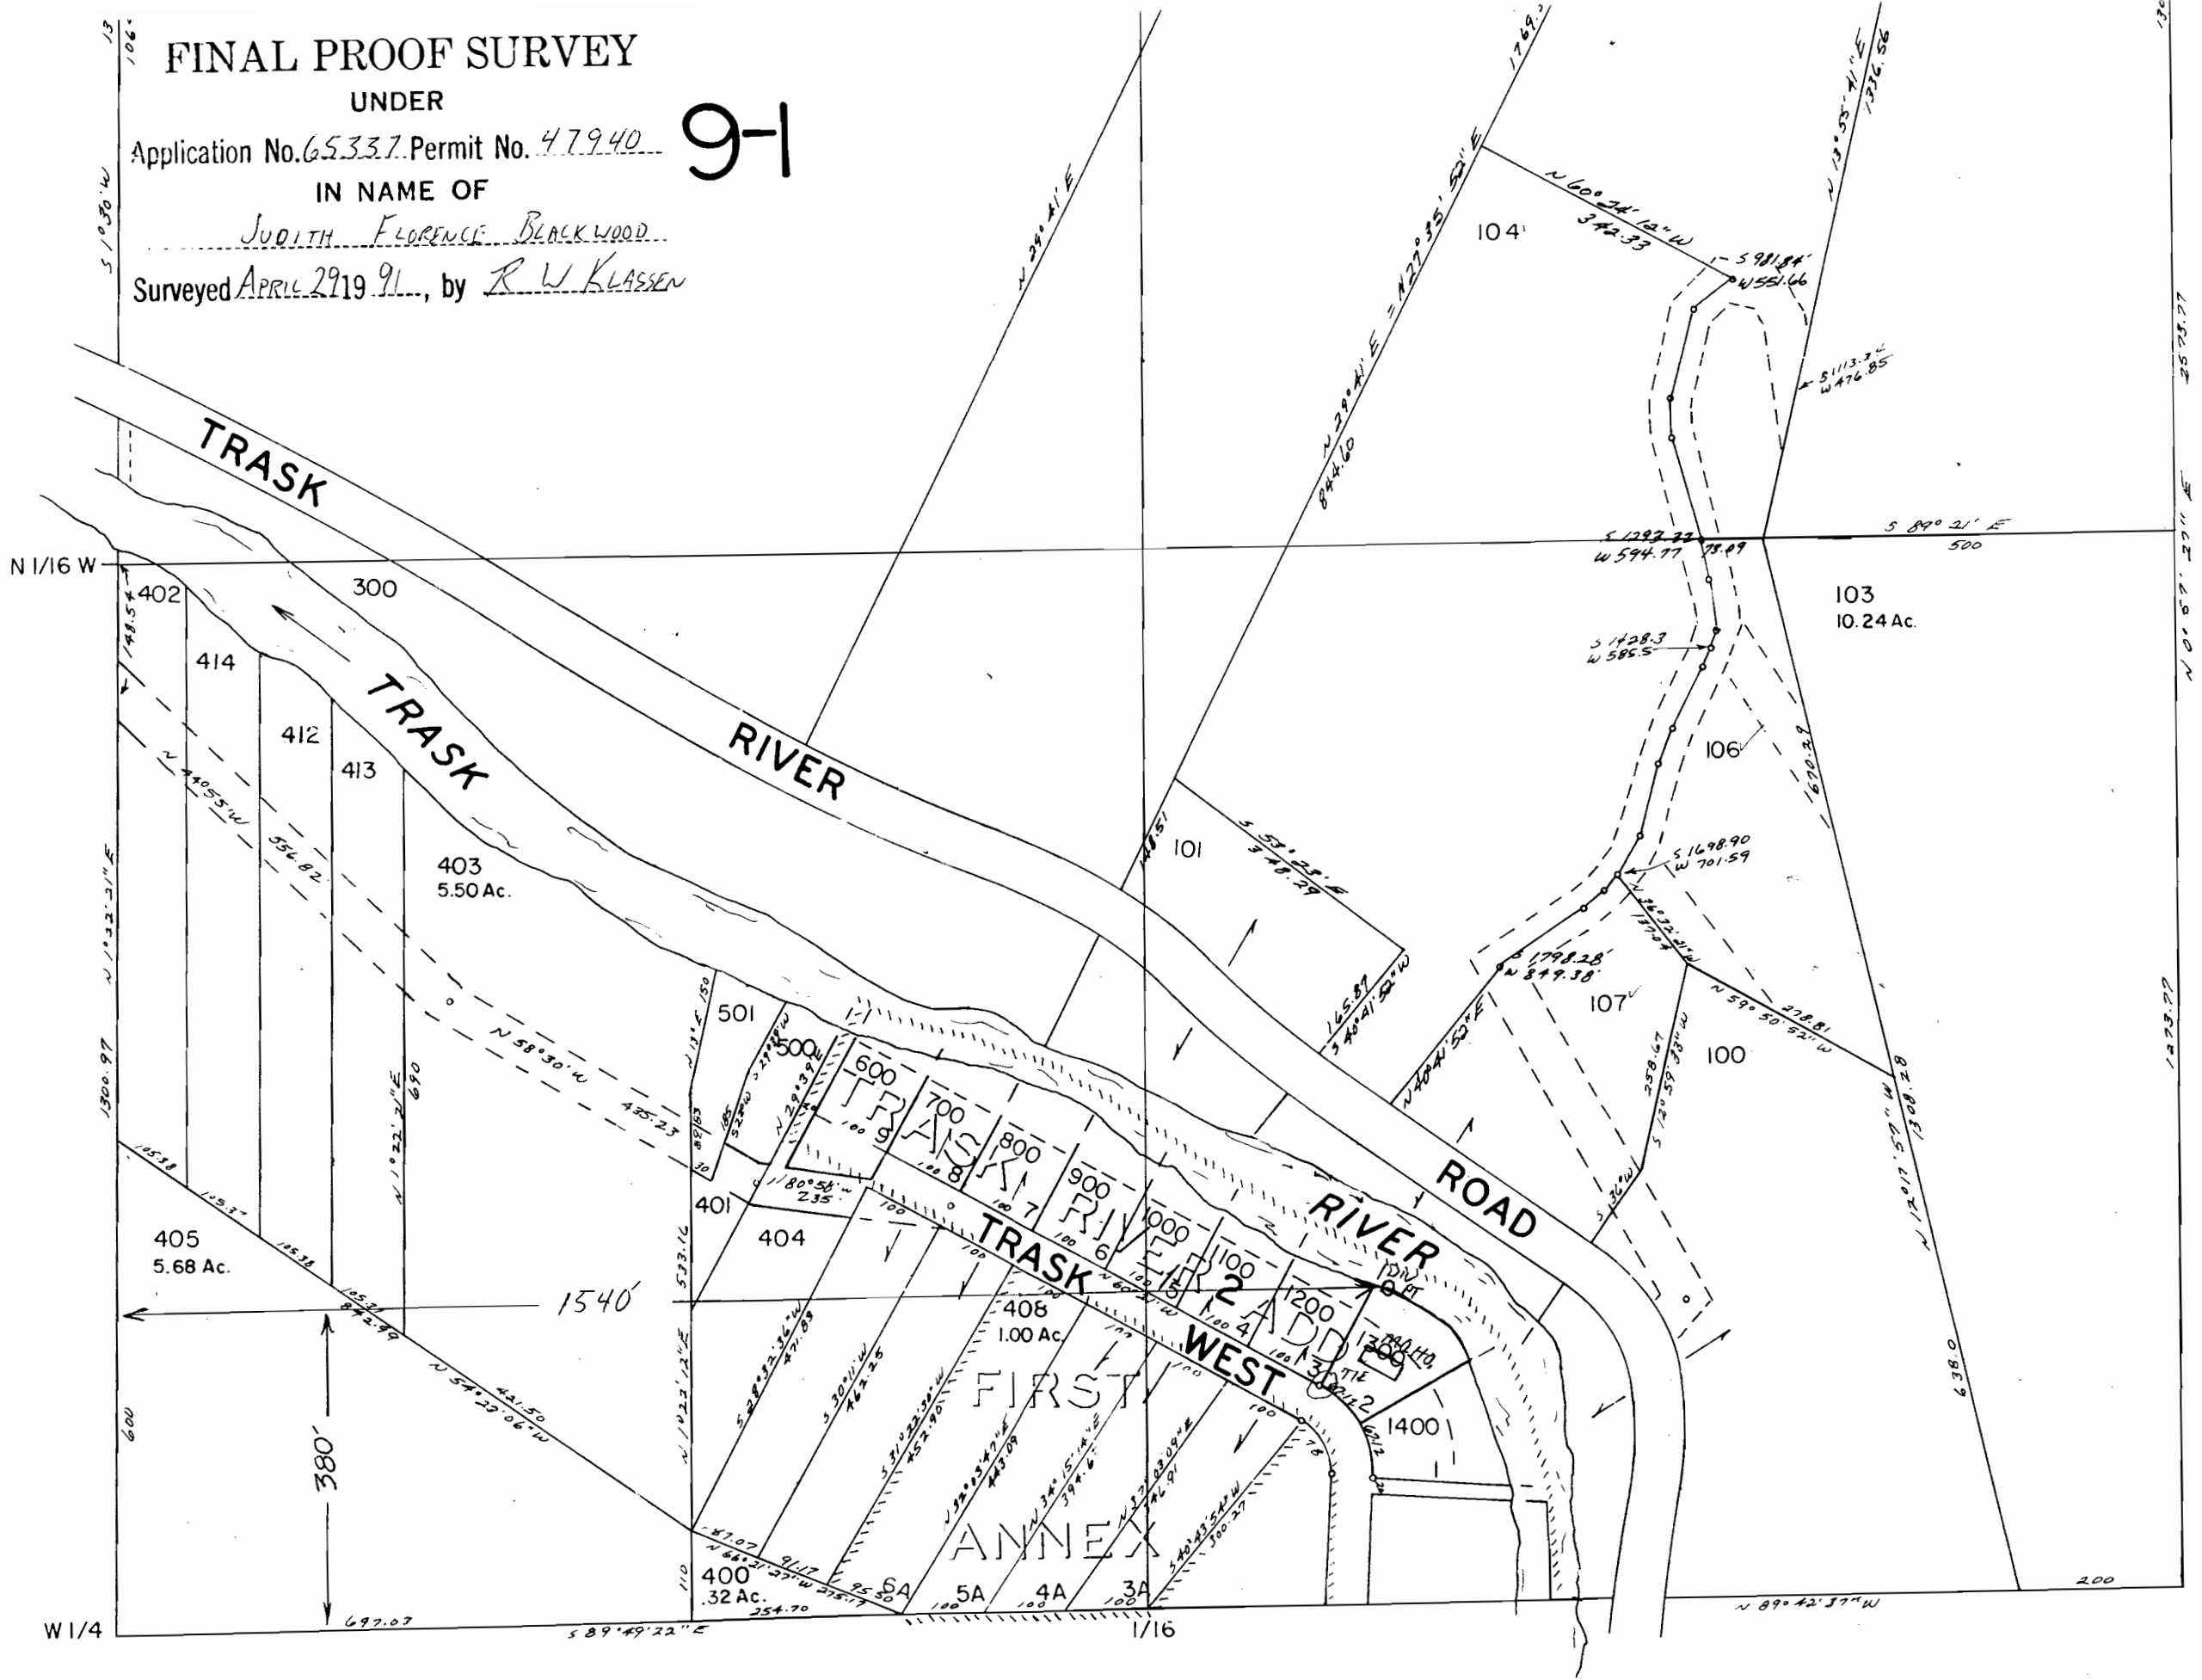

SEE MAP IS R

SEE MAP IS 8 25C