


T. 26 S., R. 7 W., W.M.

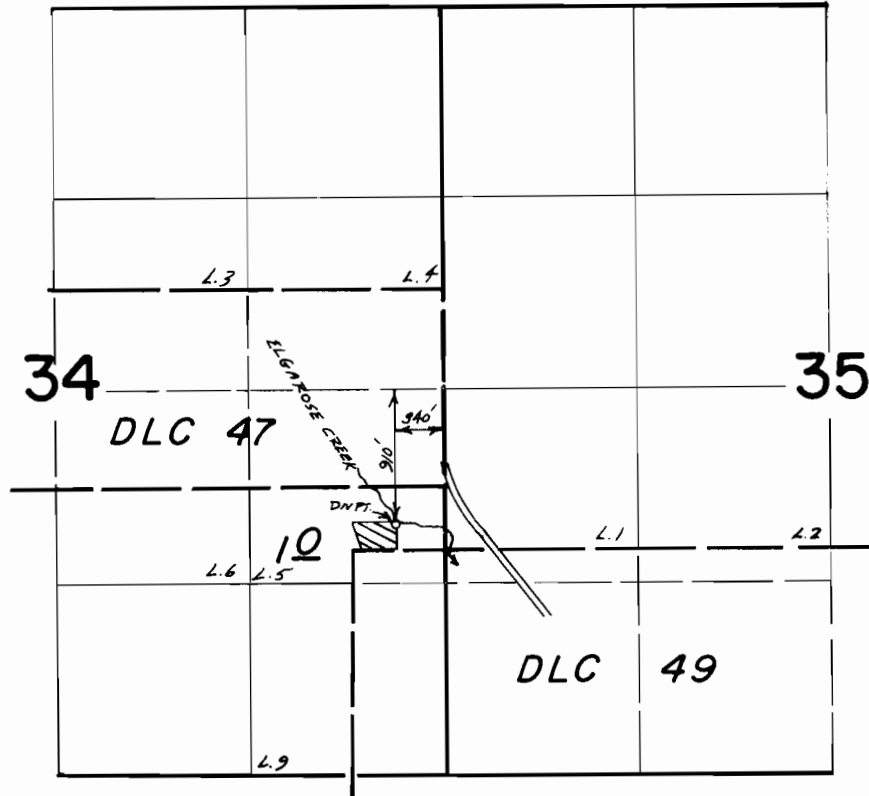

Scale 1" = 1320'

FINAL PROOF SURVEY
UNDER

Application No. ~~66938~~ Permit No. ~~48112~~.....
IN NAME OF

EARL R. & SUSANNA F. CONKEY

Surveyed Aug. 23, 1990, by S. James.....