



T. 11 S., R. 11 W., W.M.

SECTION 11

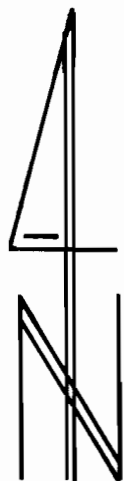

1" = 400'

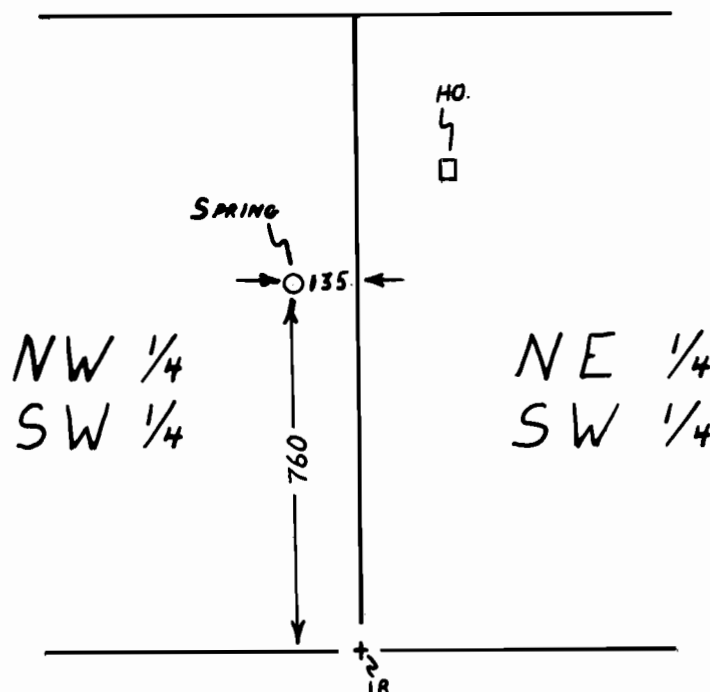

FINAL PROOF SURVEY

UNDER

Application No. 68269 Permit No. 49260

IN NAME OF

Lawrence Dale Andre

Surveyed May 21, 1991, by Russell W. Klassen