


RECEIVED

SEPT 2 1983
WATER RESOURCES DEPT.
SALEM, OREGON

T 11 S R 39 E WM

Section 36

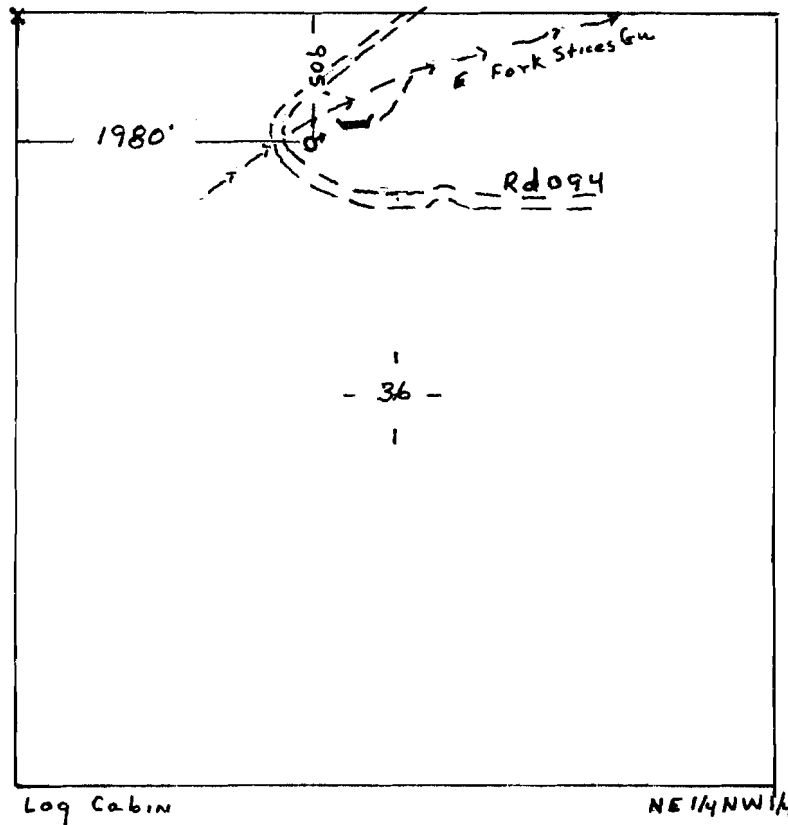

Application No. 66633
Permit No. 49794