


T. 32 S., R. 4 W., W. M.

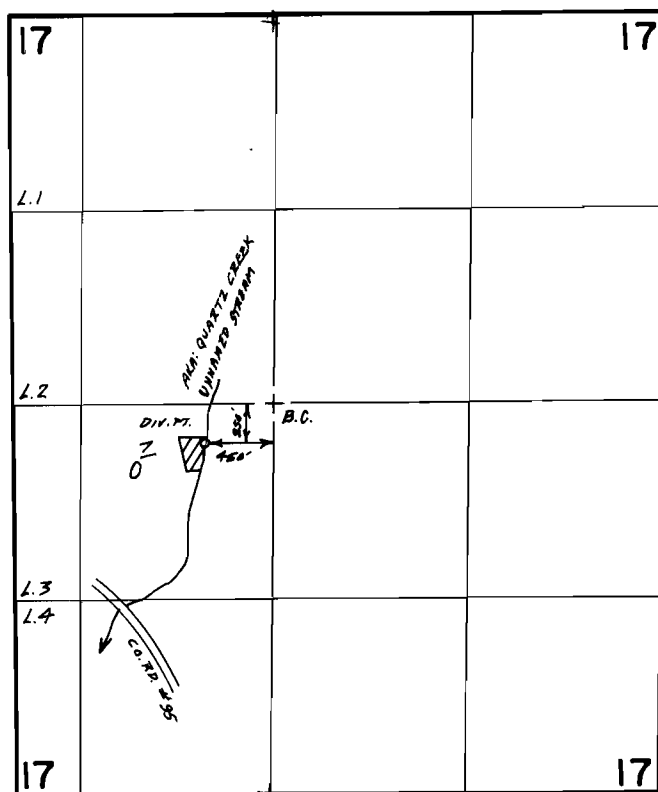

Scale 1"=1320'

**FINAL PROOF SURVEY  
UNDER**

Application No. 68543 Permit No. 49612....  
IN NAME OF

JERROLD R. & LUCY M. COOLEY

Surveyed July 10, 1990, by S. James.....