



SEE MAP  
2S 1 1

N02°26'E

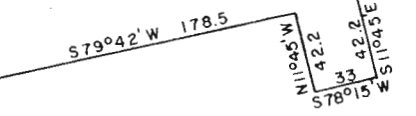


700  
508 Ac  
City of Tigard

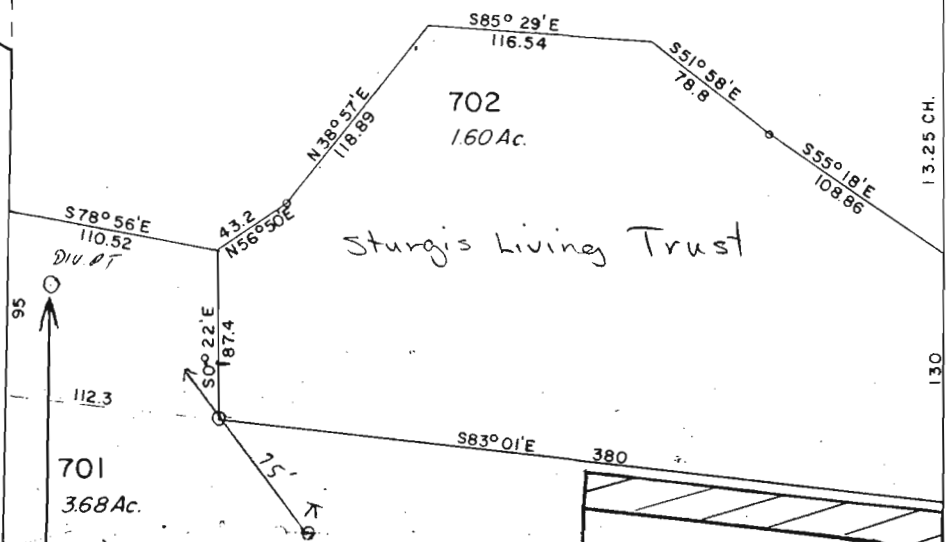

701  
368 Ac

Sturgis Living Trust


702  
160 Ac

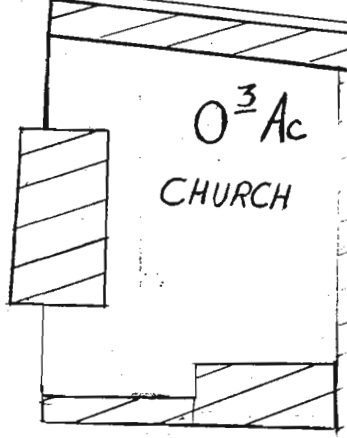

HALL BLVD.  
S.W.

600  
8.03 Ac.

23-74

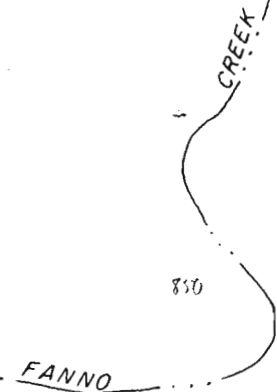

1" = 100'

### FINAL PROOF SURVEY

UNDER

Application No. 69015. Permit No. 50106

IN NAME OF

TIGARD CHRISTIAN CHURCH

Surveyed June 26 1991, by R.W. KLASSEN

500  
5.00 Ac.

FANNO CREEK

RAILROAD

RAILROAD

RAILROAD

MAR 6 1980

21142-  
2S 1 2DA

S.W. OMARA C.R. 567 STREET

SEE MAP  
2S 200

15.47 CH. NORTH &  
2.29 CH. WEST OF  
RE-ENT. COR ON  
SOUTH BNDRY W.  
GRAHM DLC 39

8 CH.  
528.0

N89°W

690  
.20 Ac

S71°E

211.87

10  
+ 18  
110  
36