


TOWNSHIP 15 SOUTH, RANGE 6 WEST, W.M.

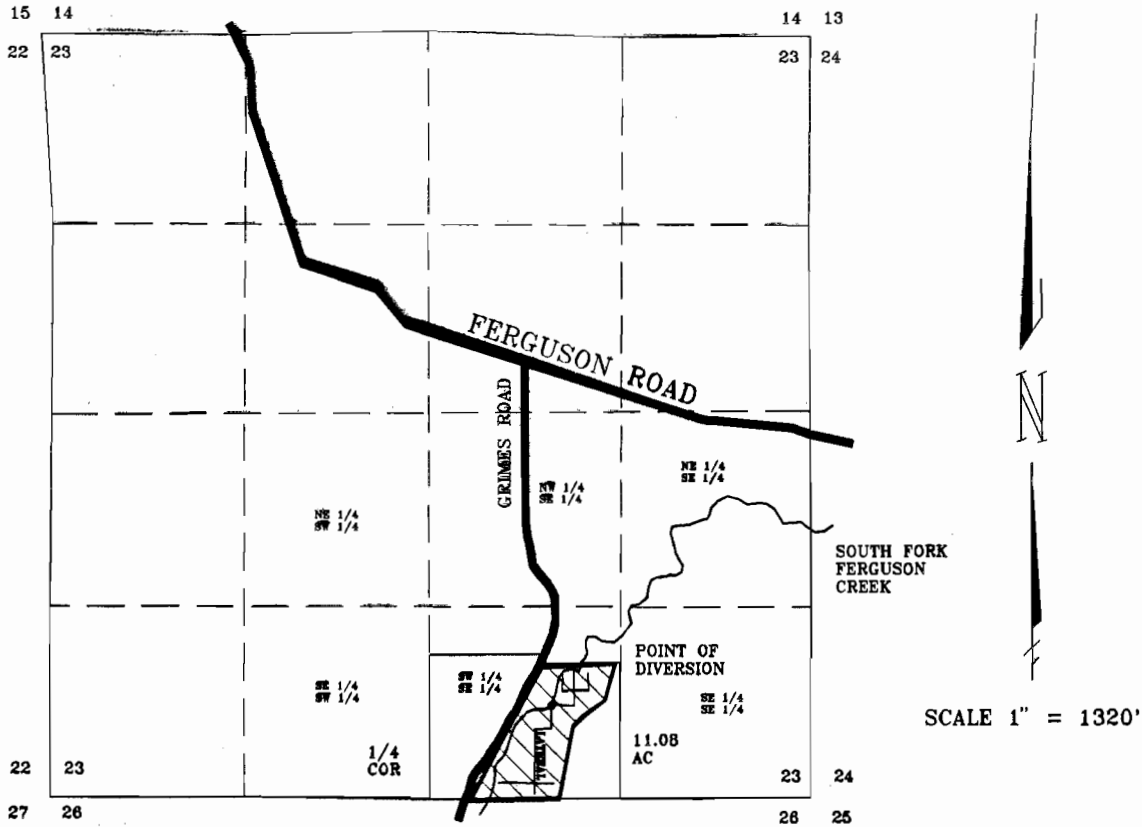

POINT OF DIVERSION
LOCATION:

641.30 FT NORTH
852.93 FT EAST OF
SOUTH 1/4 CORNER
SECTION 23.



AREA OF FINAL PROOF

FINAL PROOF SURVEY MAP
PER
APPLICATION #69599 PERMIT #50254
FOR

JOHN H. NEUMEISTER
CATTAIL CREEK FARM
95348 GRIMES ROAD
JUNCTION CITY, OREGON 97448
PH (503) 998-8505

BY
STEPHEN H. FORD INC.
1120 BAILEY HILL ROAD #5
EUGENE, OREGON 97402
PH (503) 344-1852
SEPTEMBER 4, 1992

NOTE:
THIS MAP WAS PREPARED FOR THE
PURPOSE OF IDENTIFYING THE
LOCATION OF THE WATER RIGHT
ONLY. IT IS NOT INTENDED TO
PROVIDE DIMENSIONS OR LOCATION
OF PROPERTY OWNERSHIP LINES.

