


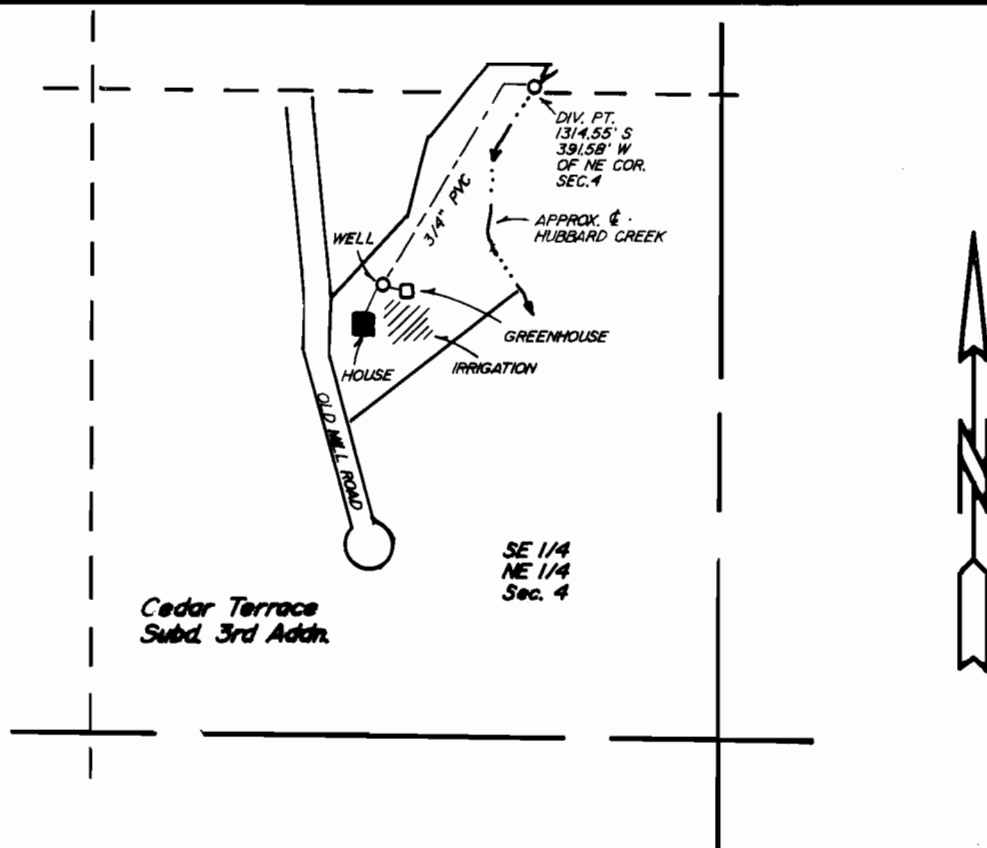

**NOTE**

*The preparation of this map is for the purpose of identifying the location of water rights only and has no intent to provide dimensions or location of property ownership lines.*

**T. 33 S., R. 15 W., W.M.  
Section 4  
FINAL PROOF SURVEY**

**UNDER  
Application # 70318 Permit # 51092**

**IN THE NAME OF**

**PETER M. & GLORIA M. BANNON**

**Surveyed September 23, 1991, by H.J. Newhouse**

**Scale 1" = 400'**

