


T. 8 S. R. 2 W. W.M.

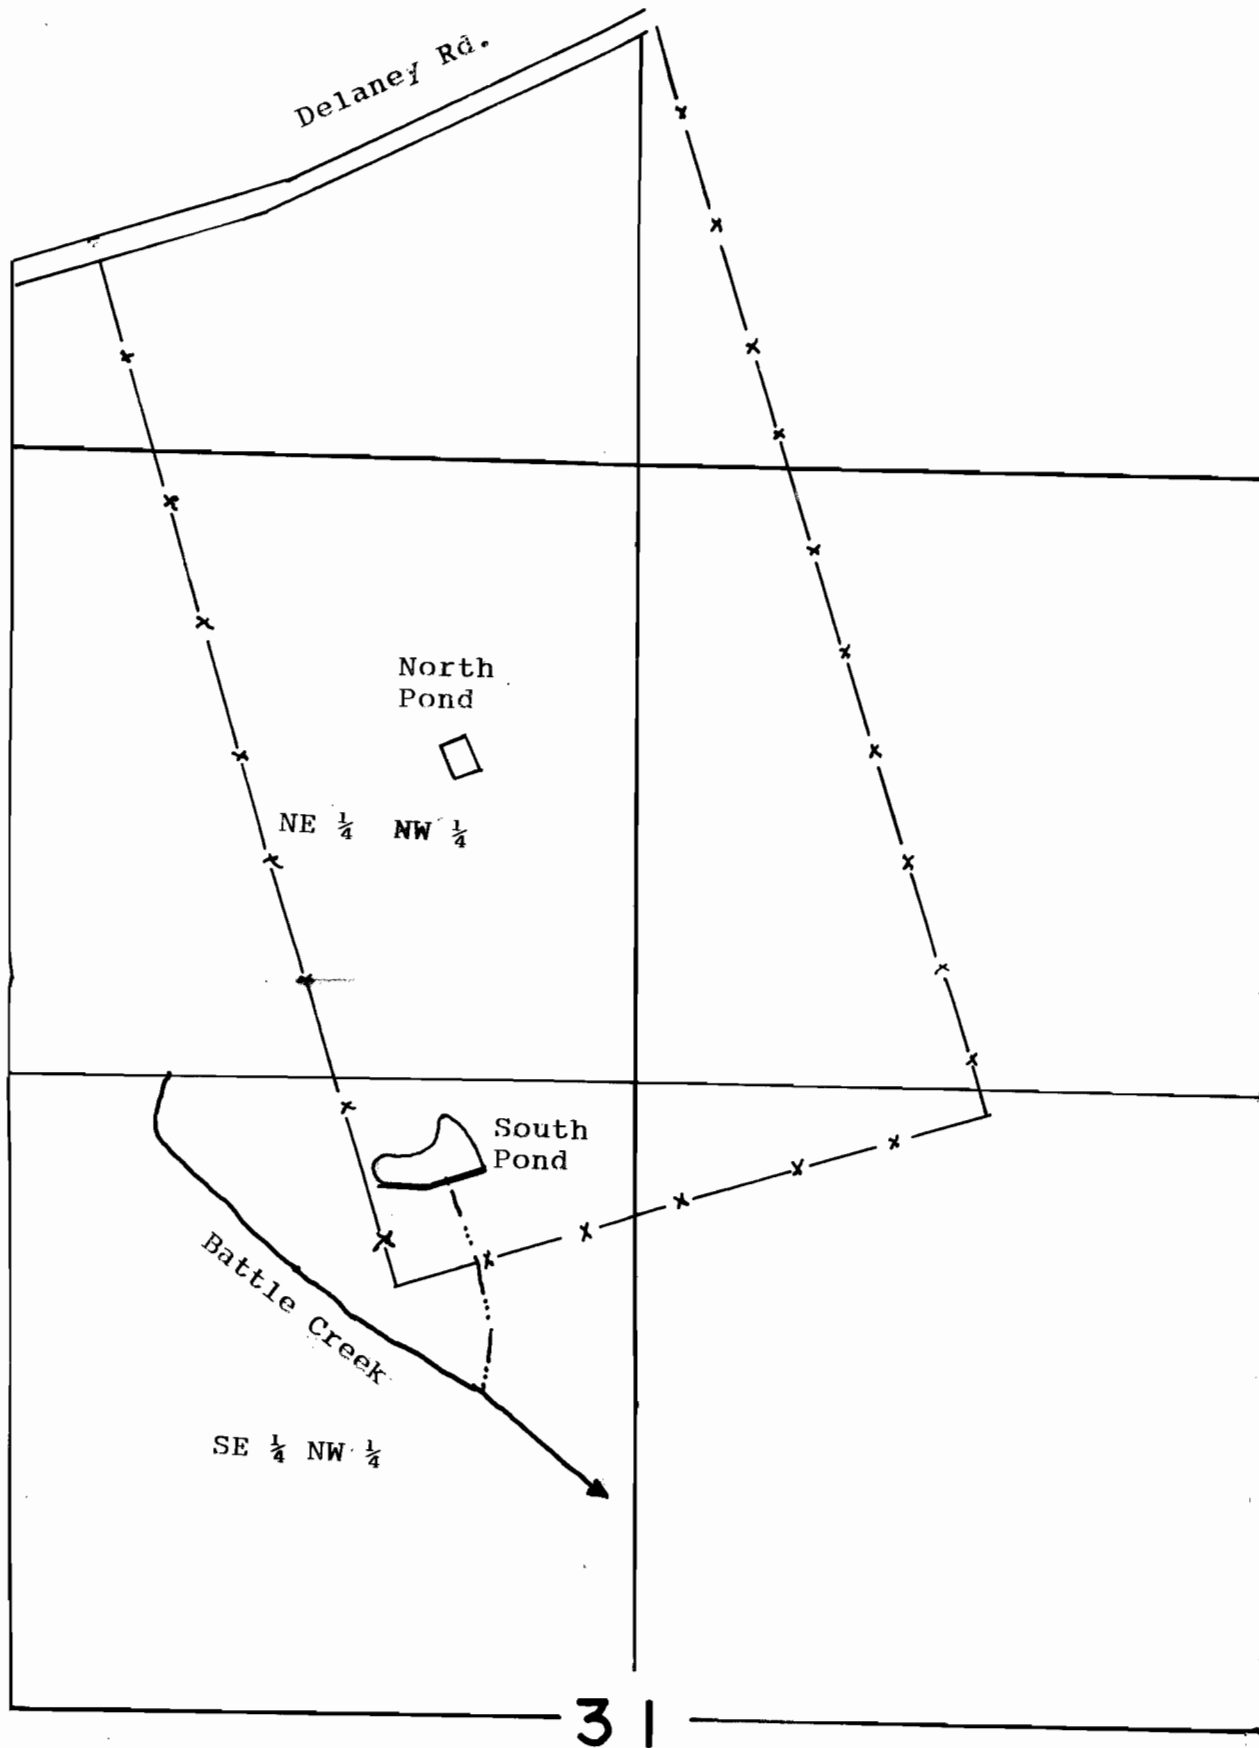

North Pond is located 665 ft S & 390 ft W
South Pond is located 1,540 ft S & 400 ft W
both from the N 1/4 Cor. Sec. 31

FINAL

WATER RIGHT MAP FOR

OTTO WEINHOLD

Appl. No. R-70378
Permit No. R-11345

THIS MAP WAS PREPARED FOR THE PURPOSE OF IDENTIFYING THE LOCATION OF A WATER RIGHT ONLY AND IS NOT INTENDED TO PROVIDE LEGAL DIMENSIONS OR LOCATION OF PROPERTY OWNERSHIP LINES.

Surveyed May 19, 1990, by

