


T.19 S., R.12 W.W.M.
SECTION 11

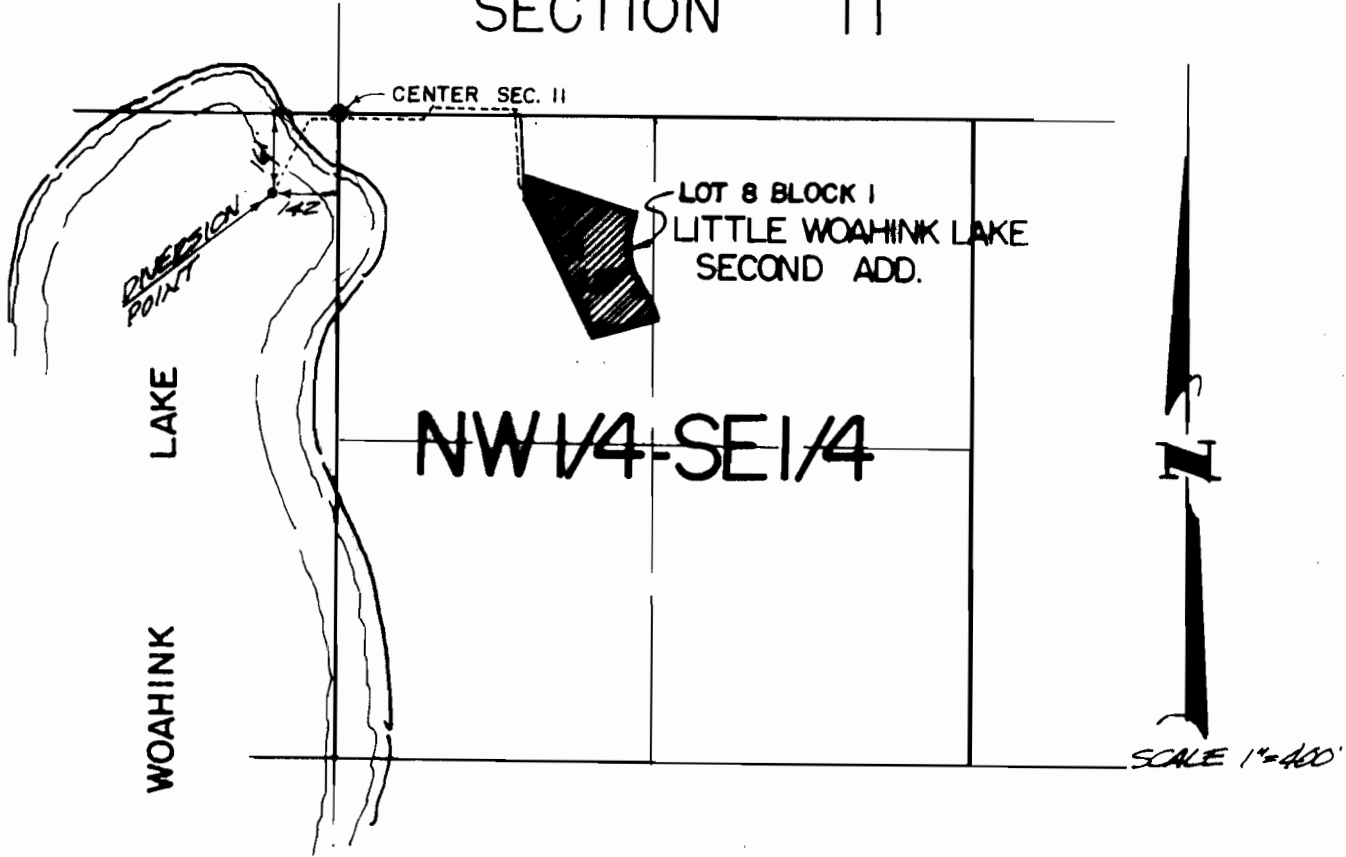

FINAL PROOF SURVEY

UNDER

APPLICATION NO. 70465 PERMIT NO. 51176

IN NAME OF

LUCILLE V. KIRK

SURVEYED JANUARY 4, 1992 BY [Signature]