


This drawing is an exhibit for a Transfer of Water Rights. It is not a Land Survey. Property lines and/or other lines of occupation shown hereon are not represented by the undersigned to meet accuracy standards of Land Surveys.

**WILLAMETTE FACTORS
 CHARBONNEAU AT WILSONVILLE**

T. 3S., R. 1W., W.M.

TRANSFER No. T-6018

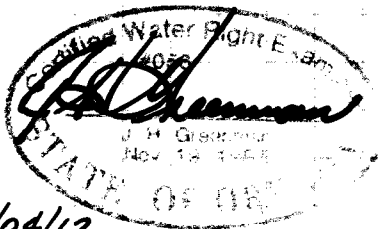

90/04/12



**HANER, ROSS &
 SPORSEEN, INC.**
 15 S.E. 82ND DR.
 GLADSTONE, OREGON 97027

**FINAL PROOF SURVEY
 TRANSFER OF WATER RIGHT**