


T. 2N. R. 4W. W.M.

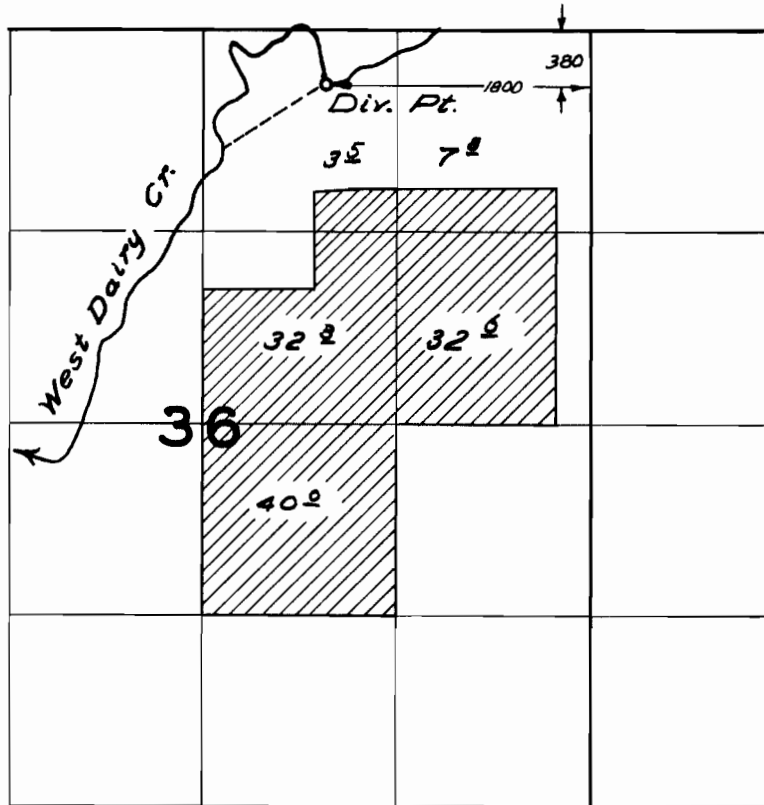

**FINAL PROOF SURVEY**  
UNDER

Application No. *27692* Permit No. *21802*  
IN NAME OF

*Henry J. Vander Zanden*

Surveyed *July 1, 1958*, by *M. Bish...*