


T. 15S., R. 12E., W. M.

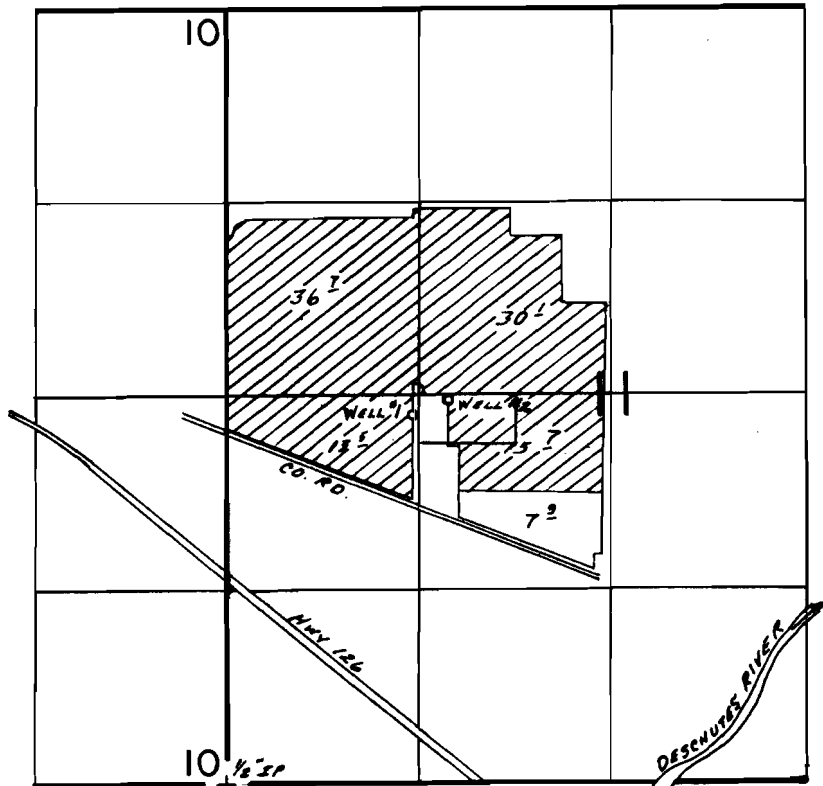

WELLS LOC.: #1-2500' N. & 1290' E.; #2-2610' N. & 1530' E., BOTH FROM SW COR. SEC. 11.

SCALE: 1" = 1320'

FINAL PROOF SURVEY UNDER

Application No. G-7840 Permit No. G-7275
IN NAME OF

JOHN WEISZ

Surveyed Oct. 11, 1988, by B.W. BISHOP

Cert: 60025
68255

RECEIVED

DATE 3-15-89

WATER MASTER DISTRICT #11

BY SWS

10/31/88

41017-179-T9R

G-7275