



T. 7S.R. 1W.W.M.

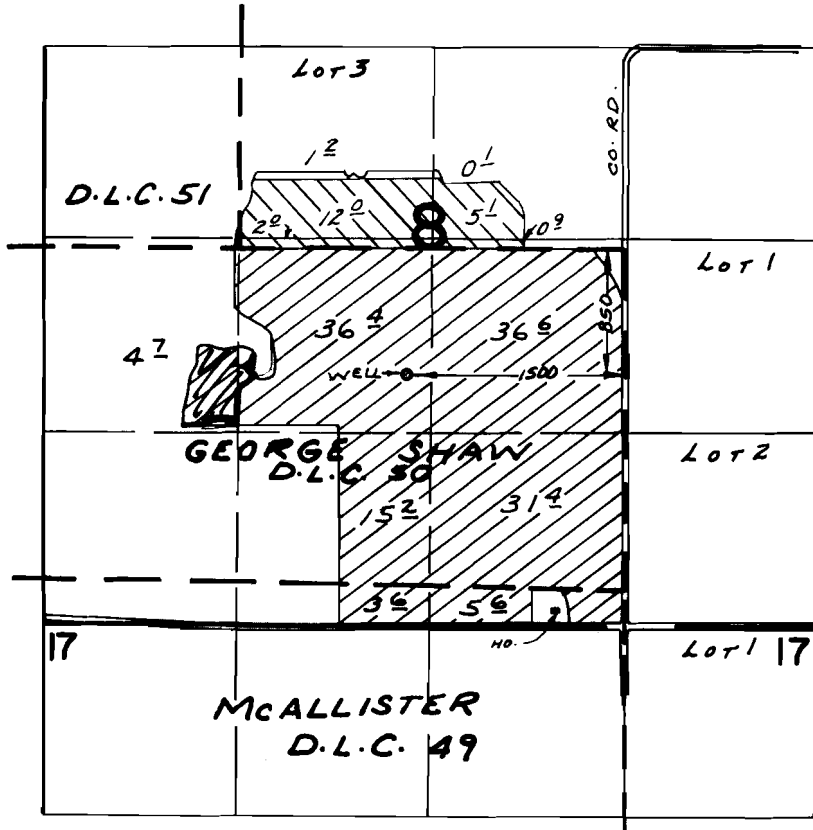

SCALE: 1" = 1320'

FINAL PROOF SURVEY UNDER

Application No. G-11316 Permit No. G-10440
G-4126 G-3881
 IN NAME OF

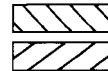

MELVIN KAUFMAN

Surveyed MAY 30, 1972, by R. MUCKEN
 Aug. 15, 1985 B.W. BISHOP