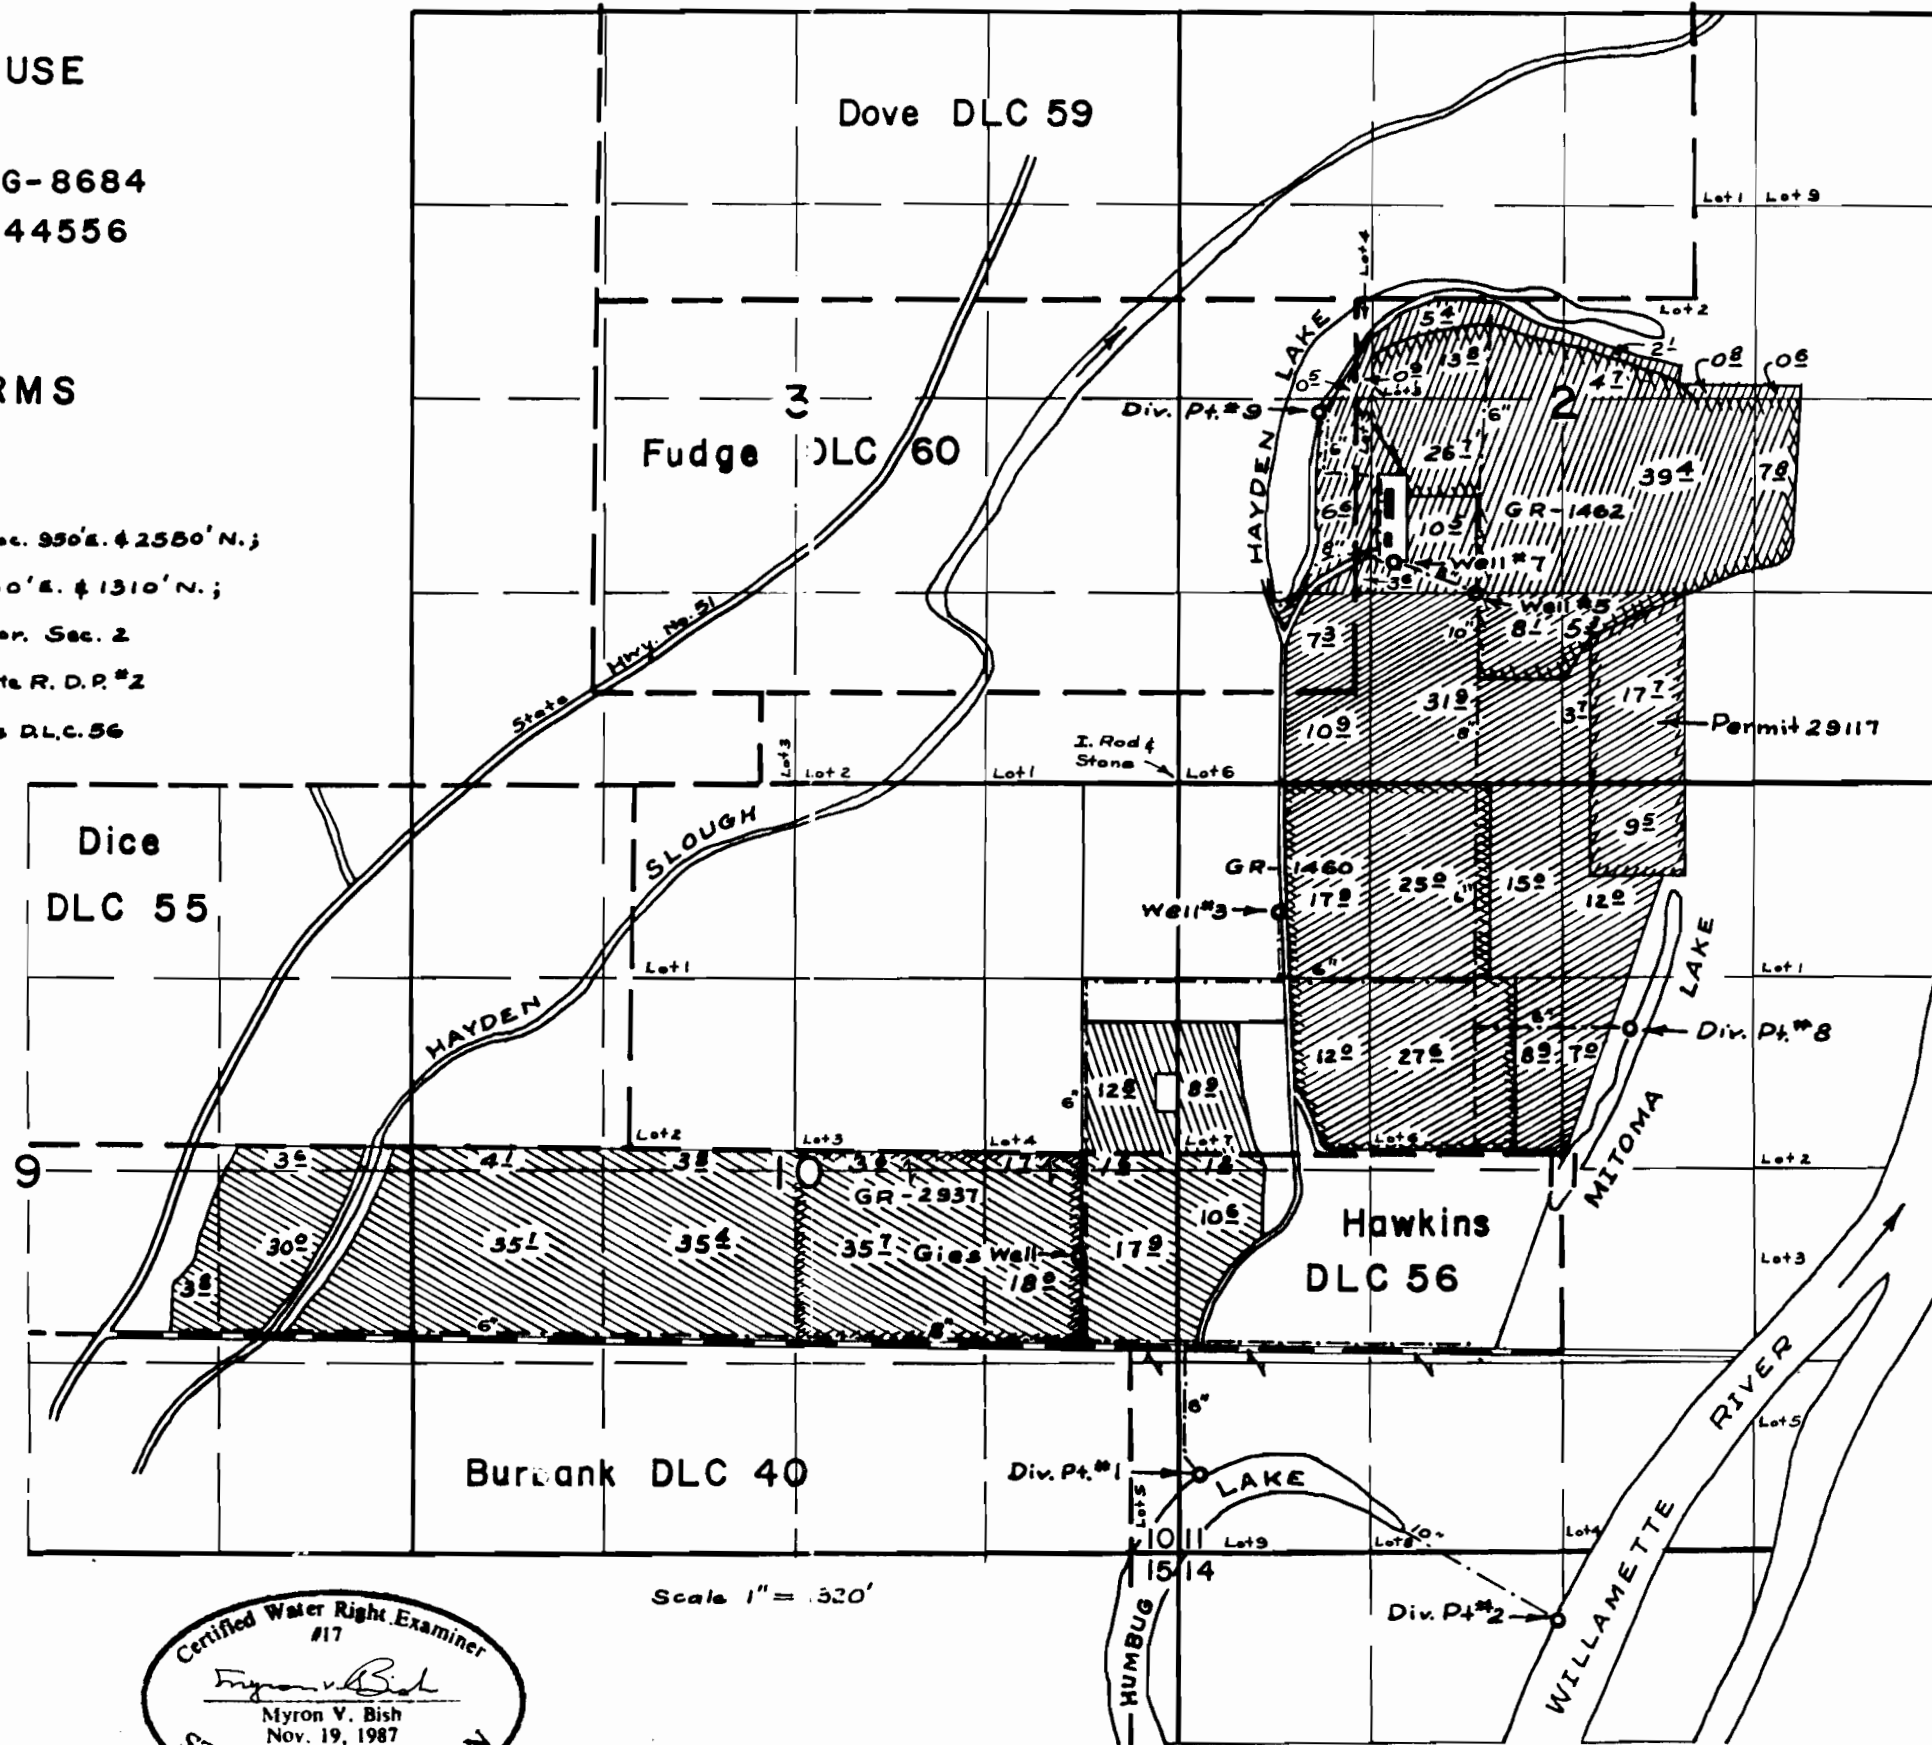


T. 8 S. R. 4 W. W. M.

CLAIM OF BENEFICIAL USE
UNDER
Applic. No. G-8709 Permit No. G-8684
Applic. No. 57240 Permit No. 44556
IN NAME OF
GREEN VILLA FARMS

Mitoma Lk. D.P.#8 loc. 3110'E. & 1670'S.; Hayden Lk. D.P.#9 loc. 990'E. & 2550'N.;
Well 3 loc. 700' E & 865'S.; Well 5 loc. 2050'E. & 1310'N.;
Well 7 loc. 1,485'E. & 1,525'N.; all from SW Cor. Sec. 2
Humbug Lk. D.P.#1 loc. 2,500'W. & 850'S., Willamette R. D.P.#2
loc. 1,850'S. & 40'W.; both from S.E. Cor. Hawkins D.L.C. 56

- Permit No. G8684
 - Well No. 3
 - Wells No. 5 & 7
- Permit No. 44556
 - Humbug Lk. D.P.#1
 - Willamette R. D.P.#2
 - Mitoma Lk. D.P.#8
 - Hayden Lk. D.P.#9
- Suppl. Acreage
 - GR-1460
 - GR-1462
 - GR-2937
 - Permit 29117



Scale 1" = 320'



THE PREPARATION OF THIS MAP IS FOR THE PURPOSE OF IDENTIFYING THE LOCATION OF THE WATER RIGHT ONLY AND HAS NO INTENT TO PROVIDE DIMENSIONS OR LOCATION OF PROPERTY OWNERSHIP LINES.

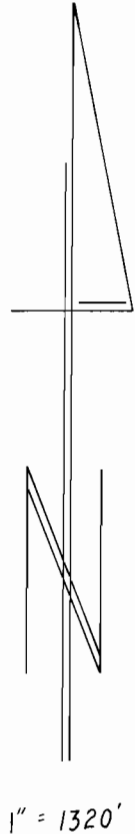
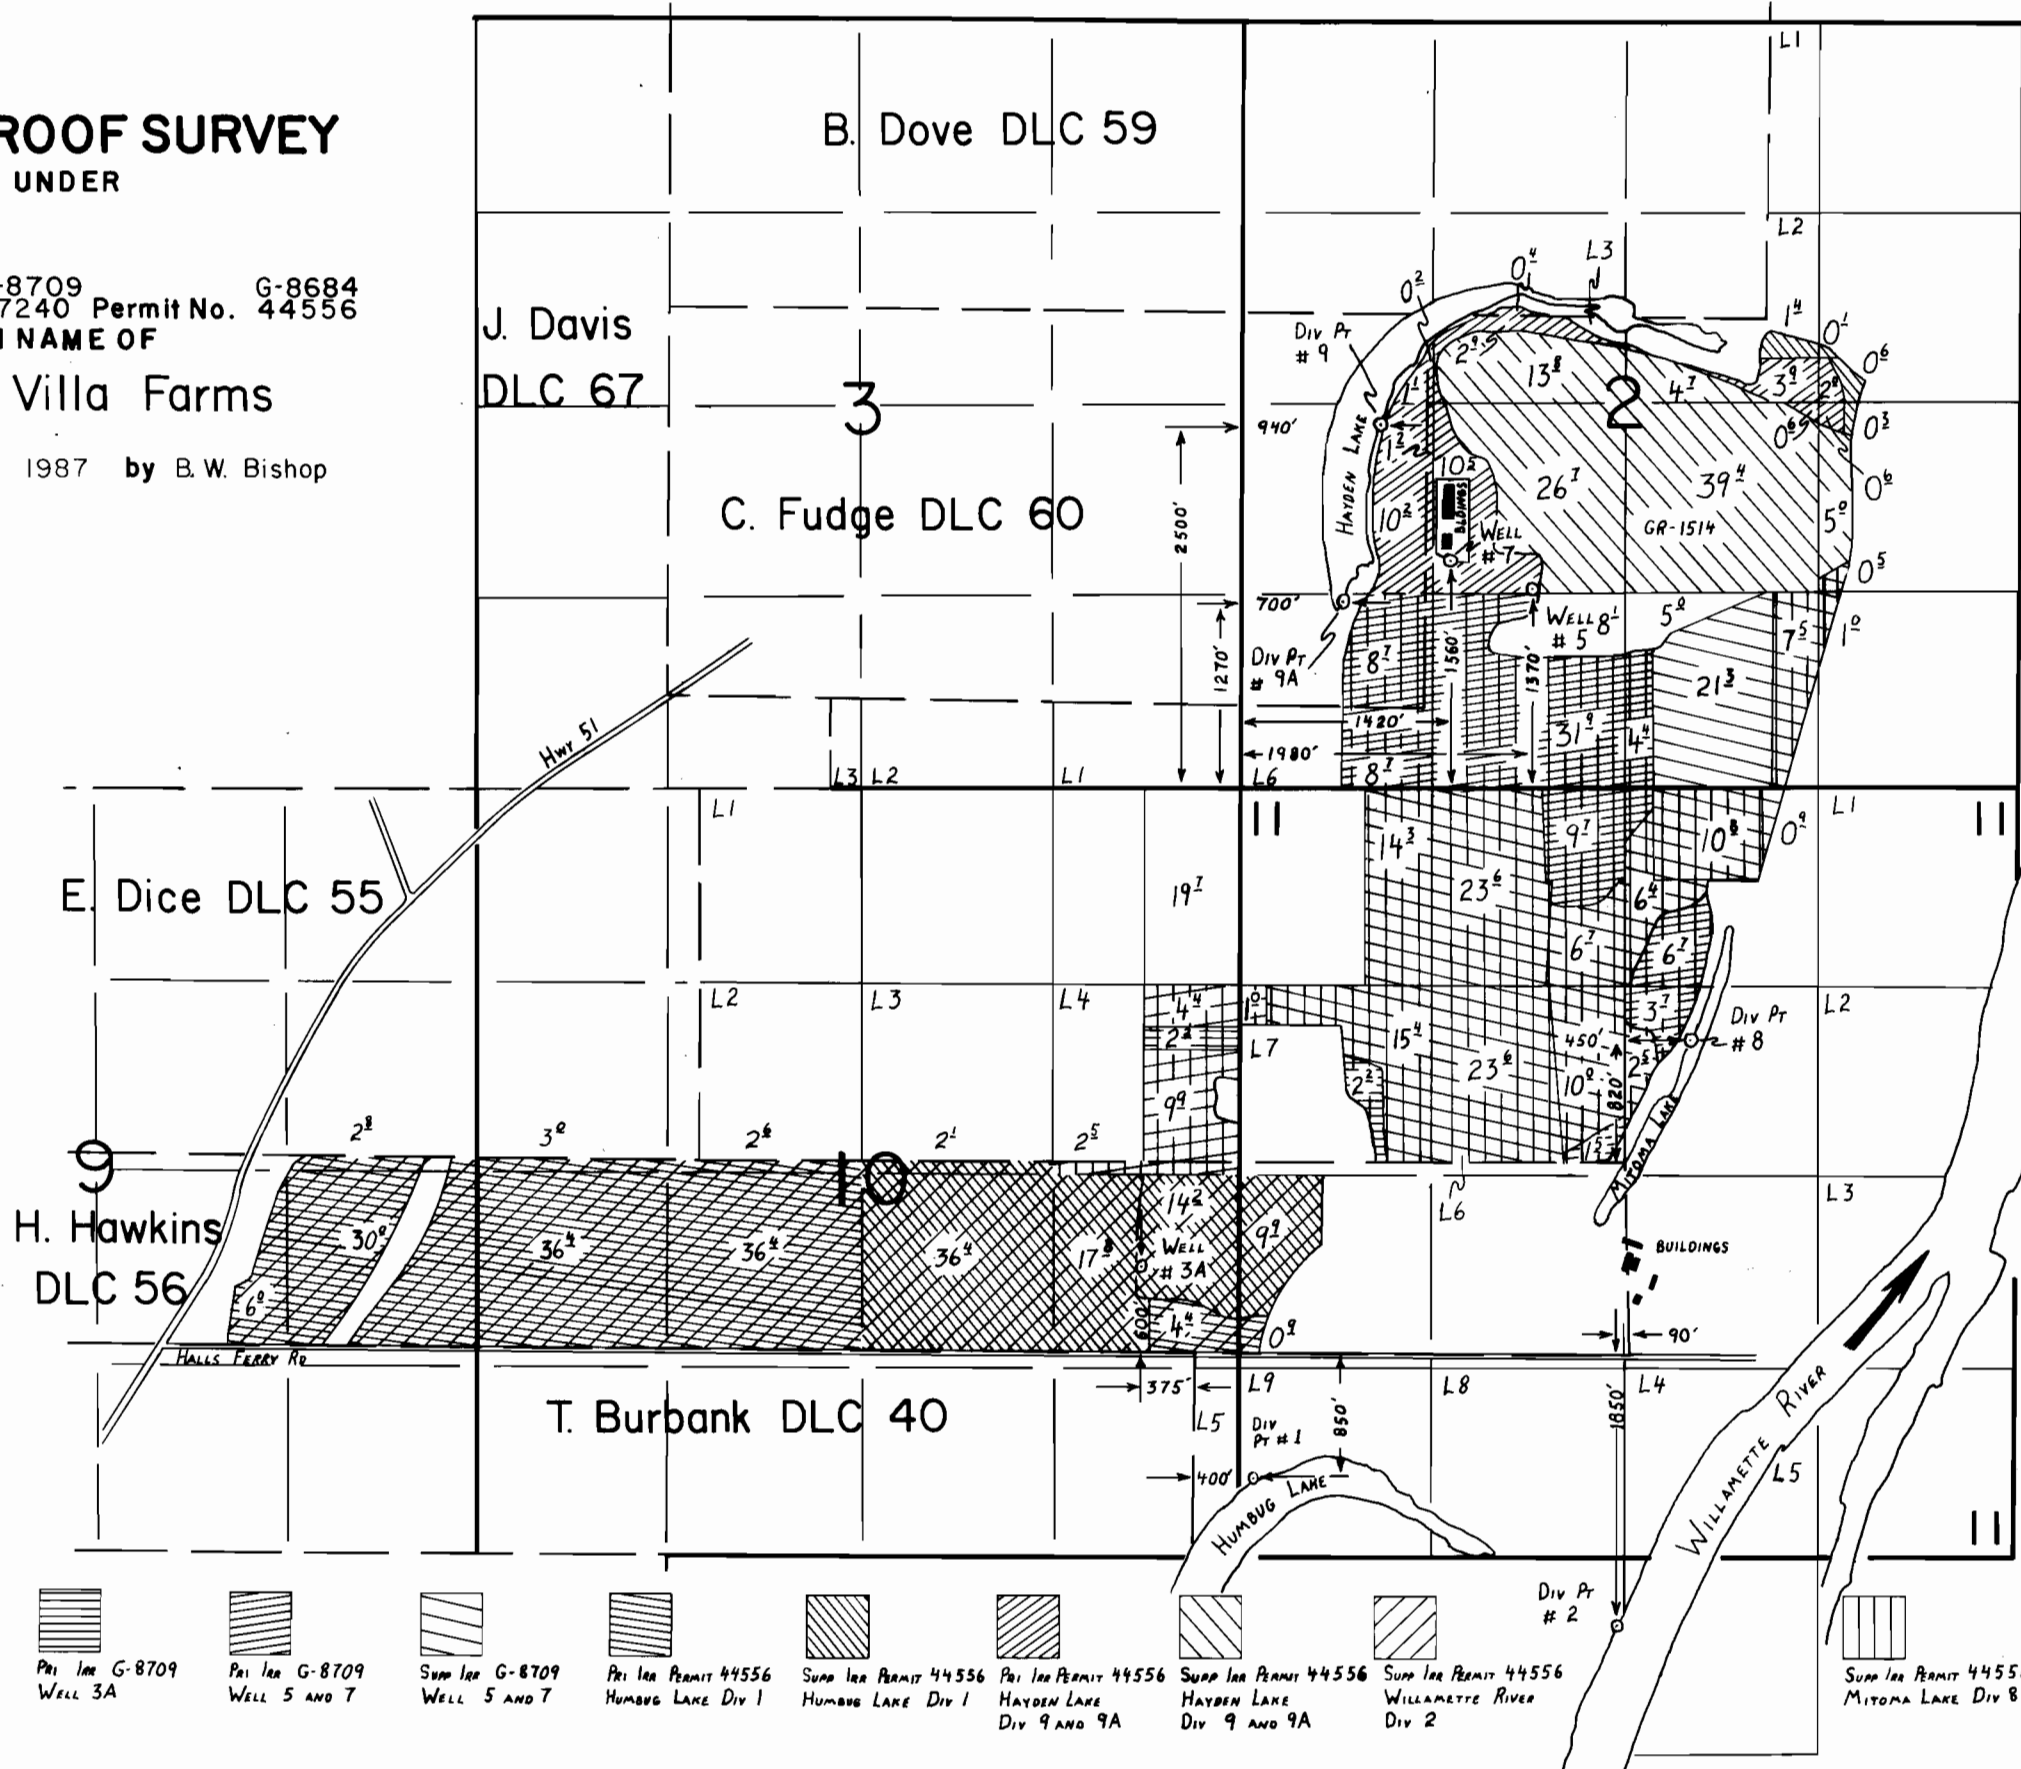
T 8 S R 4 W WM

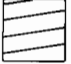
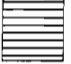

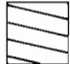
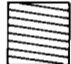


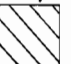
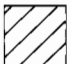

FINAL PROOF SURVEY UNDER

Application No. G-8709 Permit No. G-8684
57240 Permit No. 44556
IN NAME OF

Green Villa Farms

Surveyed Oct 29 1987 by B. W. Bishop



- 
 Supp lra G-8709
WELL 3A
- 
 Pri lra G-8709
WELL 3A
- 
 Pri lra G-8709
WELL 5 AND 7
- 
 Supp lra G-8709
WELL 5 AND 7
- 
 Pri lra PERMIT 44556
HUMBUG LAKE Div 1
- 
 Supp lra PERMIT 44556
HUMBUG LAKE Div 1
- 
 Pri lra PERMIT 44556
HAYDEN LAKE
Div 9 AND 9A
- 
 Supp lra PERMIT 44556
HAYDEN LAKE
Div 9 AND 9A
- 
 Supp lra PERMIT 44556
WILLAMETTE RIVER
Div 2
- 
 Supp lra PERMIT 44556
MITOMA LAKE Div 8