


T. 26 S., R. 15 E., W.M.

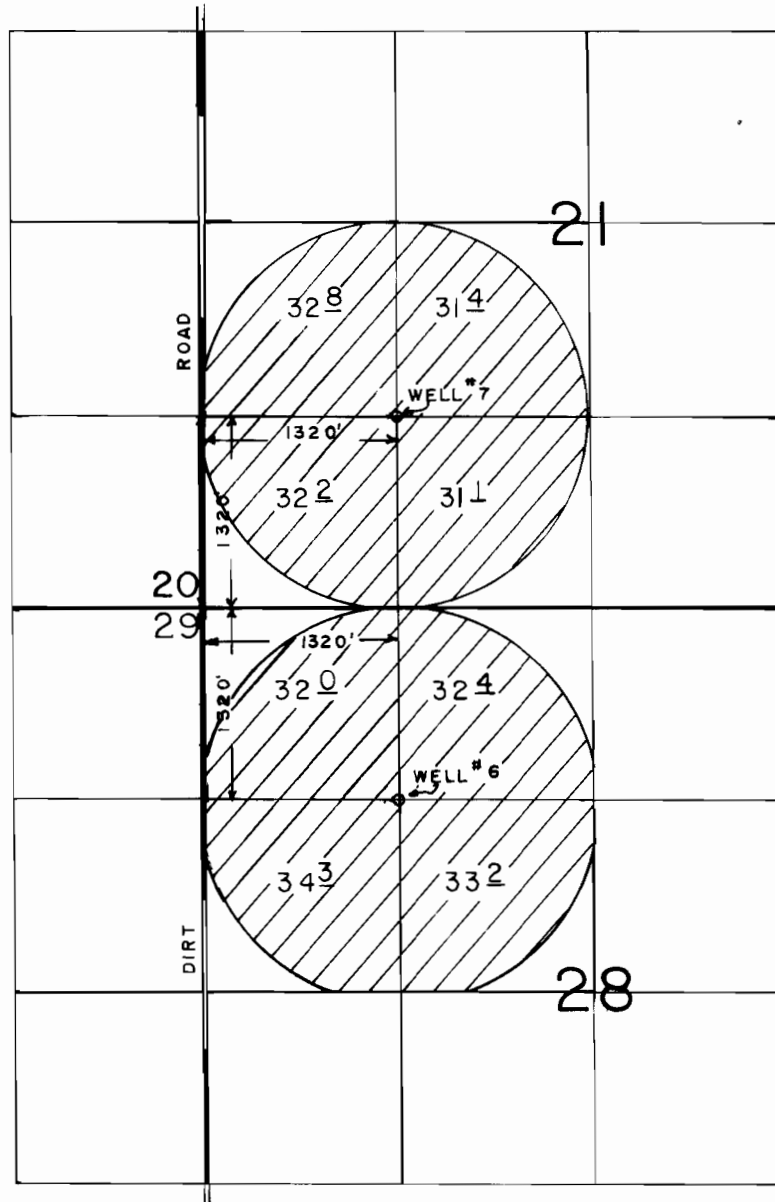

SCALE 1"=1320'

FINAL PROOF SURVEY
UNDER

Application No. G-11246 Permit No. G-10804
IN NAME OF

SAM DINSDALE

Surveyed APRIL 6, 1992, by B.W. BISHOP