


RECEIVED

MAY 02 1991


T.7S., R.2W., W.M.

WATER RESOURCES DEPT.
SALEM, OREGON

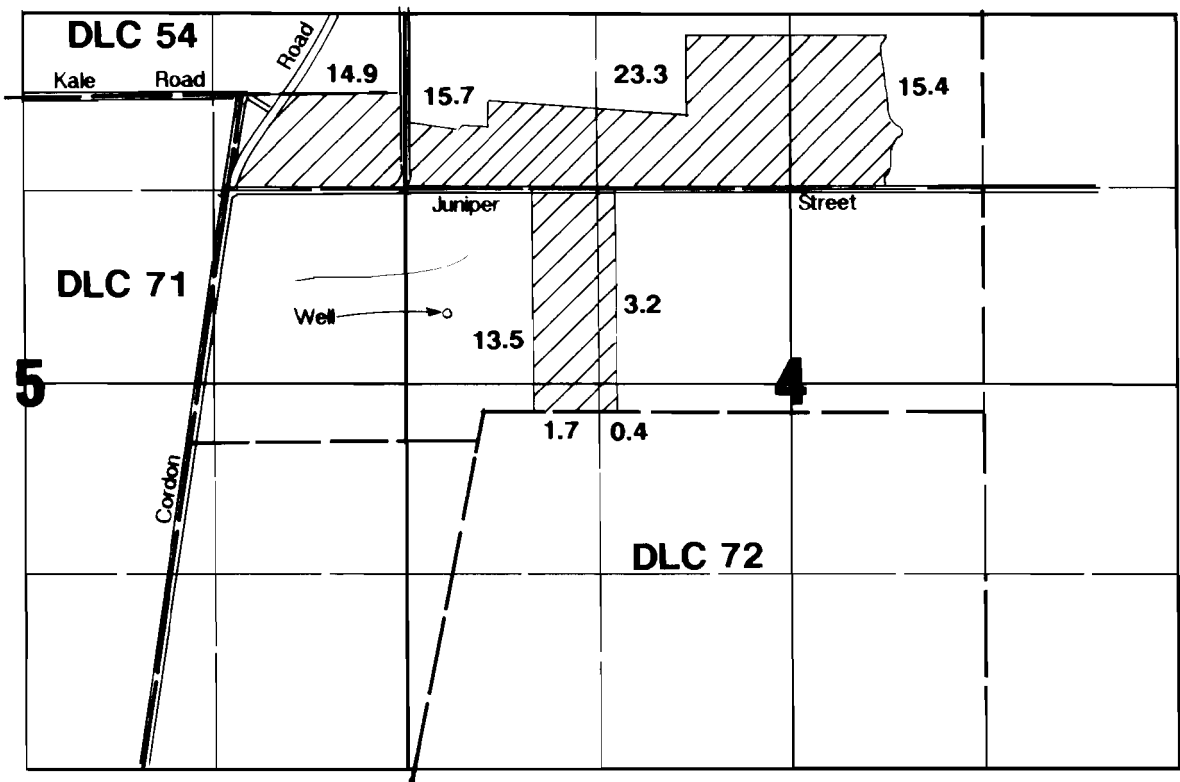

Well located 480'N & 300'E from W1/4 corner Section 4.

Final Proof Survey

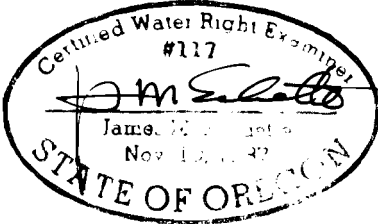

Application #: G-11772 Permit #: G-11036

In Name Of

Marlan C. Johnson

Surveyed on April 10, 1991 by JM Schuette

THIS MAP WAS PREPARED FOR THE PURPOSE OF IDENTIFYING THE LOCATION OF A WATER RIGHT ONLY AND IS NOT INTENDED TO PROVIDE LEGAL DIMENSIONS OR LOCATION OF PROPERTY OWNERSHIP LINES.