


T 3 S , R 38 E , WM

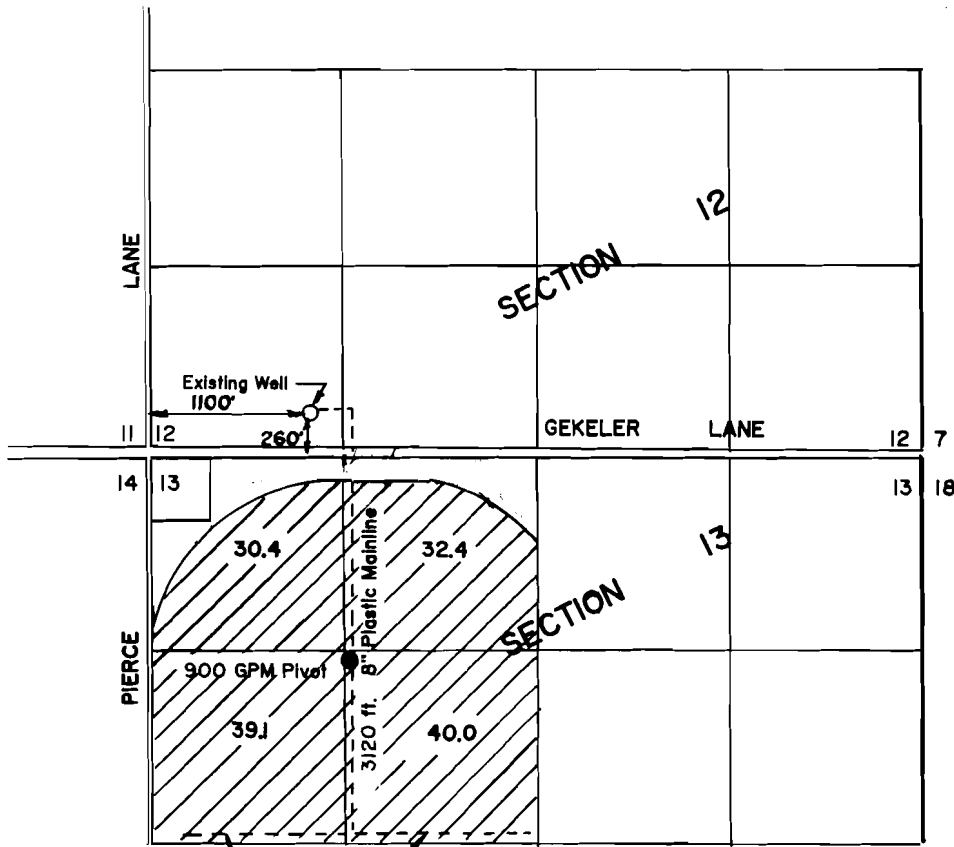

Scale 1" = 1320'


4" Steel portable hand line

5" Plastic buried line for head line, 1300 ft.

POINT OF DIVERSION : 260 Ft. North and 1100 ft. East, from the Southwest Corner of Section 12. (Existing Well)

FINAL PROOF SURVEY UNDER

G - 12028 IN NAME OF PAUL C. RUDD

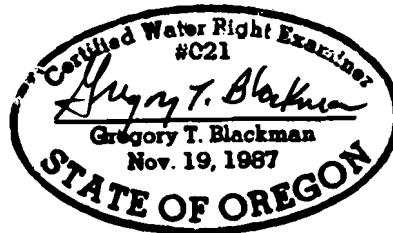

SURVEYED JANUARY 3, 1991 BY

Gregory T. Blackman