


T.2S., R.2E., W.M.

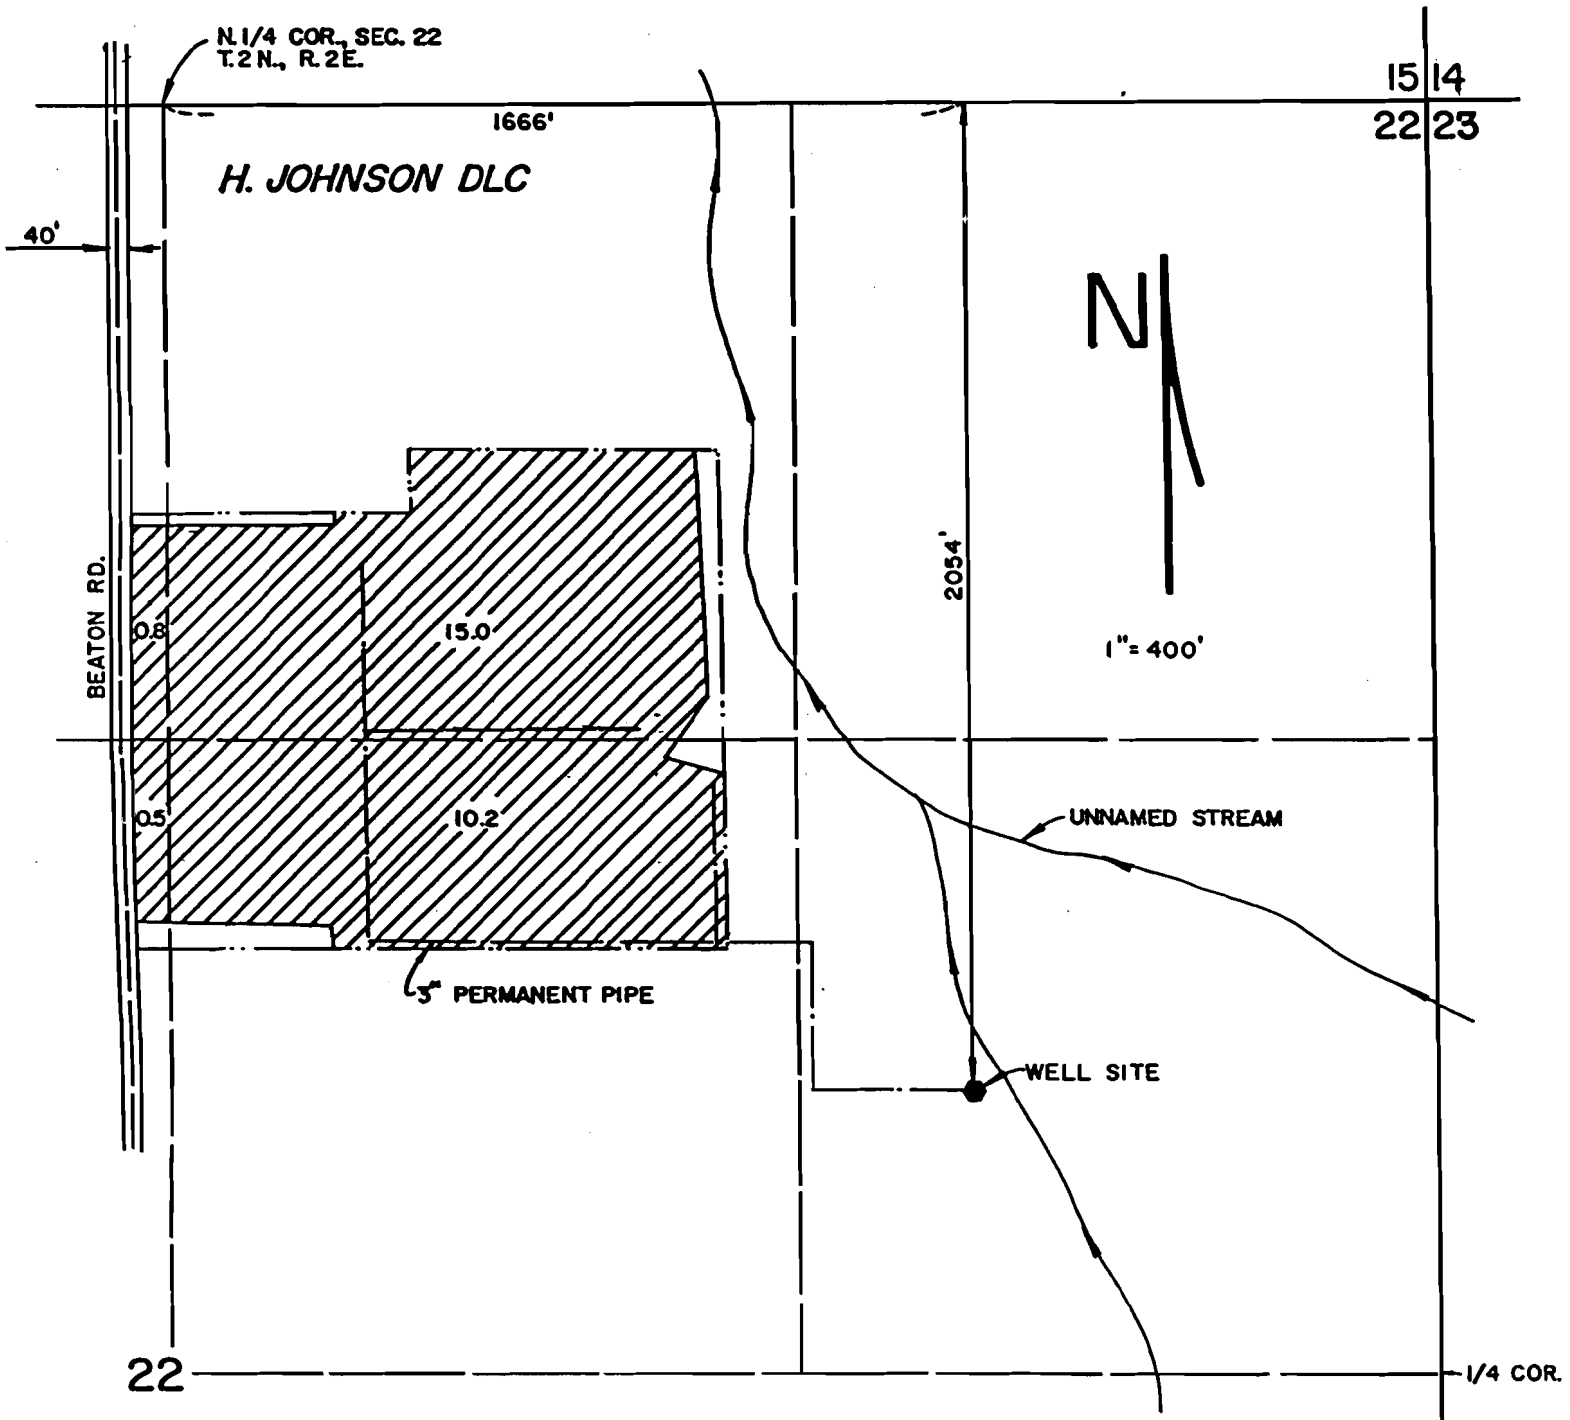


FINAL PROOF SURVEY UNDER

APPLICATION NO. G-12237 PERMIT NO. G-11180

IN NAME OF

SIRI PRODUCE, INC.

SURVEYED SEPT. 25, 1991 BY

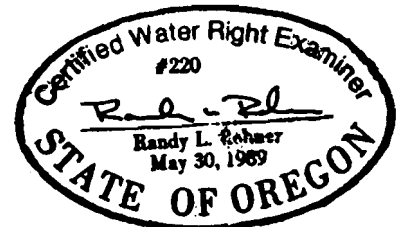

NOTE: The Purpose Of This Map Is To Identify The Location Of The Water Right Only And Has No Intent To Provide Dimensions Or Location Of Property Ownership Lines.