


T. 32 S., R. 2 E., W.M.

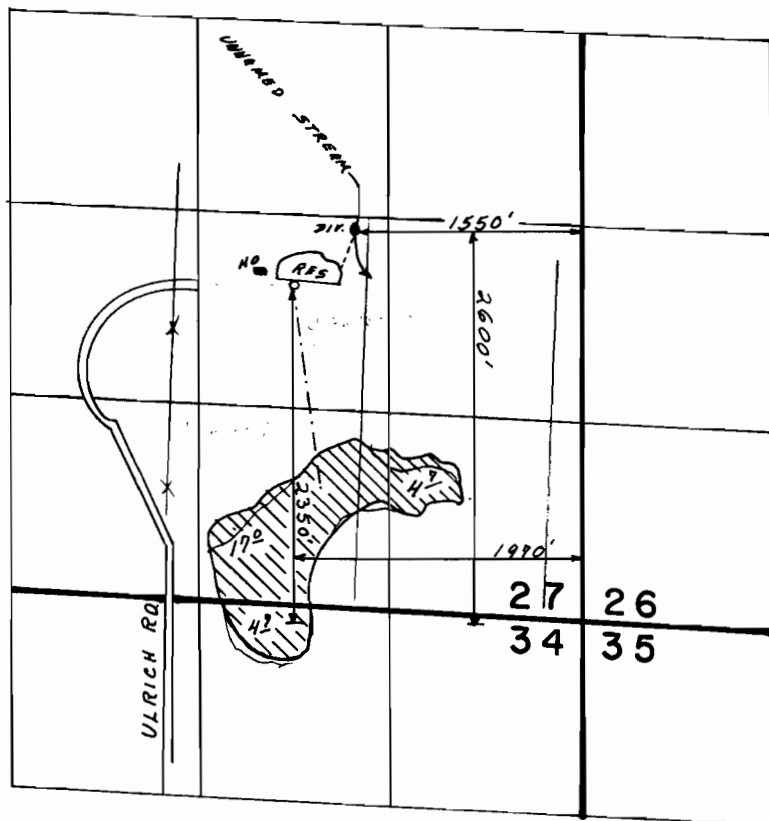

Scale : 1" = 1320'

FINAL PROOF SURVEY

UNDER

R-48848

R-5927

Application No. 48849 Permit No. 36605

IN NAME OF

FRANK J. LEE

Surveyed JUL. 22. 1986, by B. S. JAMES