


T. 32 S., R. 4 W., W.M.

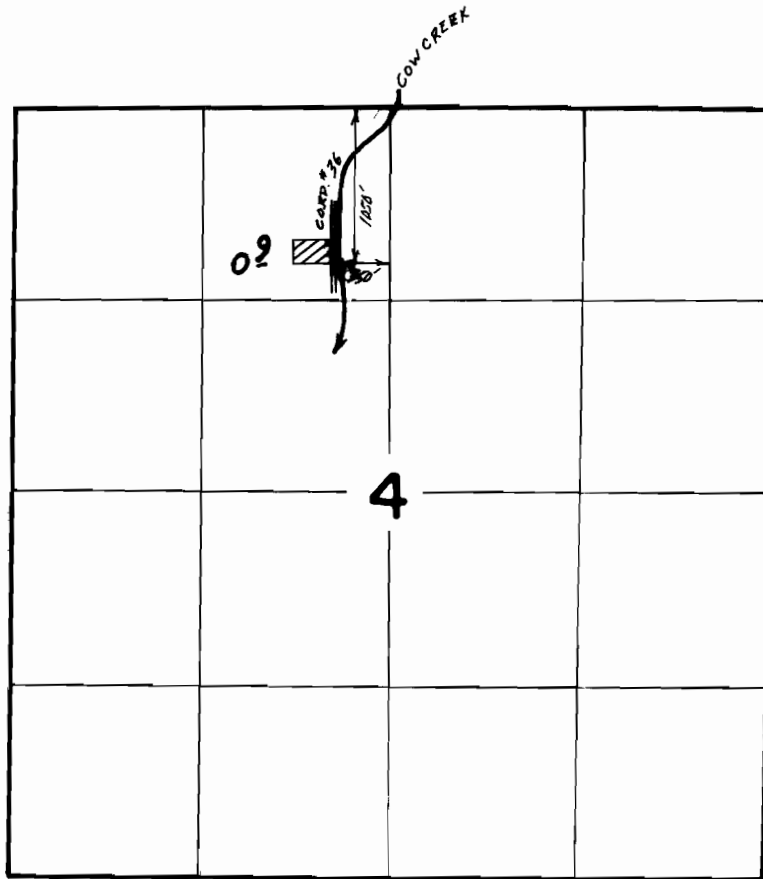

Scale 1"=1320'

**FINAL PROOF SURVEY
UNDER**

Application No. 57722 Permit No. 43485...
IN NAME OF

..... FLORENCE P. LAPP

Surveyed July.10., 1990, by S. James.....