


T. 2 N., R. 2 W., W.M.

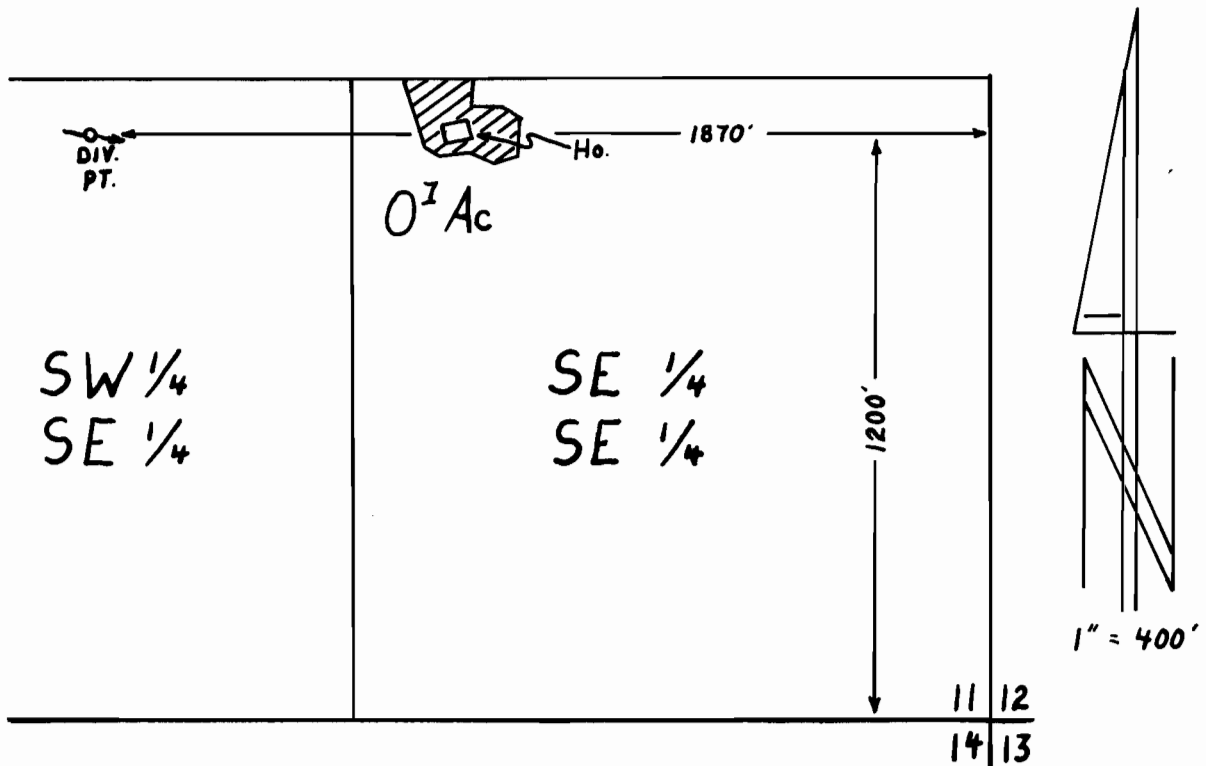

FINAL PROOF SURVEY

UNDER

Application No. 58754 Permit No. 44813
IN NAME OF

James David Baughn

Surveyed August 7, 1991, by R.W. Klassen