


T. 2 N., R. 2 W., W.M.

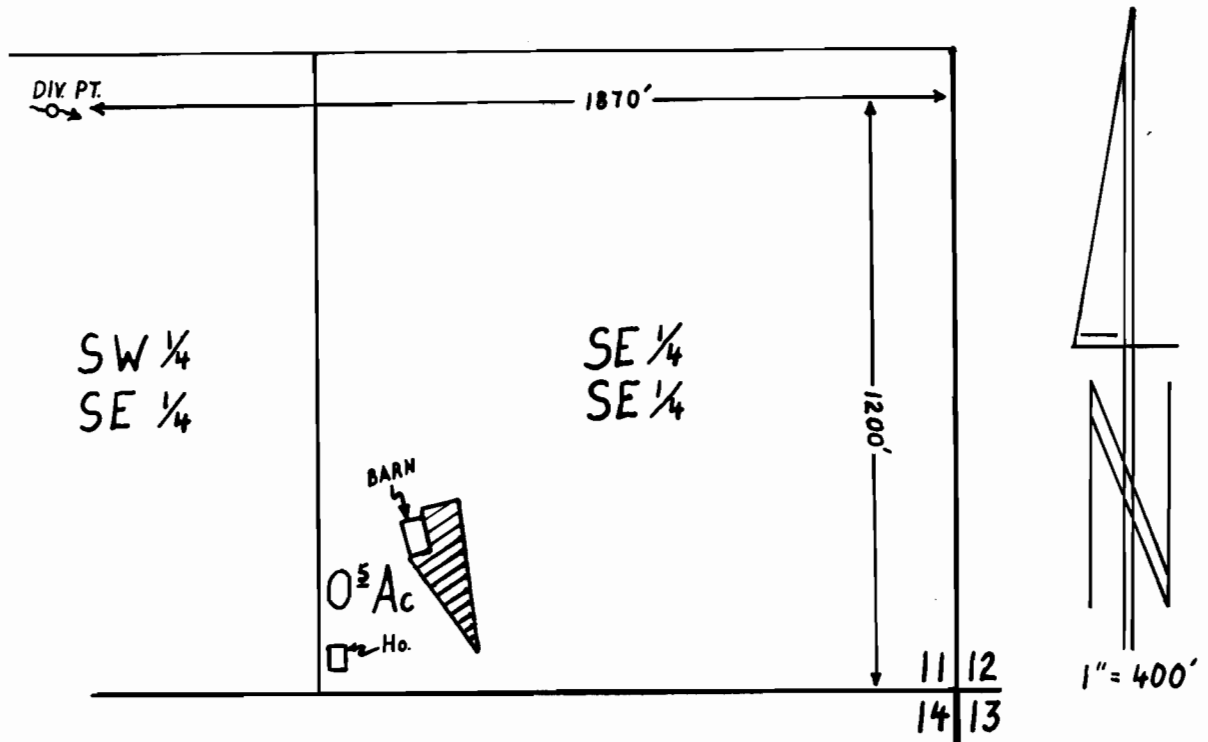

FINAL PROOF SURVEY

UNDER

Application No. 58762 Permit No. 44737
IN NAME OF

Larry H. & Moran N. Nelson

Surveyed August 7, 1991, by R.W. Klassen